

15-169-19050-00-00


STATE OF KANSAS
STATE CORPORATION COMMISSION

Form CP-4

Give All Information Completely
Make Required Affidavit
Mail or Deliver Report to:
Conservation Division
State Corporation Commission
211 No. Broadway
Wichita, Kansas

WELL PLUGGING RECORD

Saline County. Sec. 23 Twp. 15 Rge. 2W (E) (W)
Location as "NE/CNW/SW" or footage from lines NE/SE/SW
Lease Owner Frank J. Black
Lease Name Hubbard Well No. 2
Office Address Box 150, McPherson, Kansas 67460
Character of Well (completed as Oil, Gas or Dry Hole) Oil
Date well completed 10-9-64 19
Application for plugging filed 7-2-69 19
Application for plugging approved 7-3-69 19
Plugging commenced 7-22-69 19
Plugging completed 7-26-69 19
Reason for abandonment of well or producing formation Dry

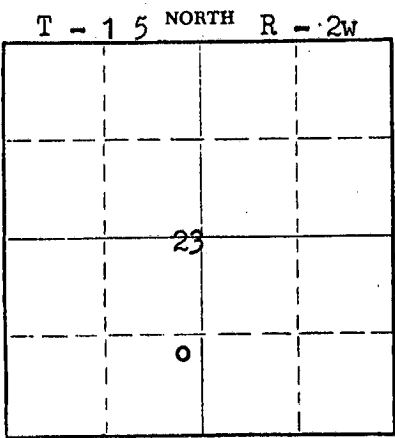

Locate well correctly on above
Section Plat

If a producing well is abandoned, date of last production 19
Was permission obtained from the Conservation Division or its agents before plugging was commenced? Yes

Name of Conservation Agent who supervised plugging of this well Hugh Scott
Producing formation Depth to top Bottom Total Depth of Well 2735 Feet
Show depth and thickness of all water, oil and gas formations.

OIL, GAS OR WATER RECORDS

CASING RECORD

FORMATION	CONTENT	FROM	TO	SIZE	PUT IN	PULLED OUT
				10-3/4"	138'	None
				7"	2732'	2279'

Describe in detail the manner in which the well was plugged, indicating where the mud fluid was placed and the method or methods used in introducing it into the hole. If cement or other plugs were used, state the character of same and depth placed, from feet to feet for each plug set.

Set plug at 150'
Rock to 140'
Run 30 sacks of cement from 140' to 80'
Mudded from 80' to 40'
Rock & 15 sacks of cement from 40' to base of cellar.

RECEIVED
STATE CORPORATION COMMISSION
JUL 31 1969
CONSERVATION DIVISION
Wichita, Kansas

(If additional description is necessary, use BACK of this sheet)
Name of Plugging Contractor Glenn & Smith Pipe Pulling Co. License #396
Address Box 156, Ellinwood, Kansas 67526

STATE OF KANSAS, COUNTY OF MCPHERSON, ss.
Frank J. Black (owner) of the above-described well, being first duly sworn on oath, says: That I have knowledge of the facts, statements, and matters herein contained and the log of the above-described well as filed and that the same are true and correct. So help me God.

(Signature) FRANK J. BLACK
Box 150, McPherson, Kansas
(Address)



Subscribed and sworn to before me this 30th day of July, 1969
July 16, 1971

Jerry Peltzman
Notary Public.

WELL RECORD

15-169-19050-00-00

LEASE: Hubbard

WELL NO. 2

ELEVATION: 1309 RB

LOCATION: NE SE SW
Sec. 23-15-2W

COMMENCED: 10/2/64

COMPLETED: 10/9/64

OPERATOR: Dale Reese

CONTRACTOR: Melland Drilling Company, Inc.
Post Office Box 783
McPherson, Kansas

CASING RECORD: 10" @ 138'/100sx
7" @ 2732'/50sx

FORMATION	LOG
clay, sand & shale	138
lime & shale	827
shale & shells	1380
shale & lime	1680
lime & shale	1830
shale & shells	2060
lime & shale	2632
shale	2705
shale	2720
Miss	2735
RTD	2735

FORMATION	LOG

RECEIVED
STATE CORPORATION COMMISSION
JUL 31 1969
CONSERVATION DIVISION
Wichita, Kansas

CERTIFICATE

State of Kansas, County of McPherson, ss.

I, Donald J. Melland, do hereby certify that the above is a true and correct copy of the log of the above named and described well, as reflected by the records of the Melland Drilling Company, Inc.

Donald J. Melland

Subscribed and sworn to before me, a Notary Public, in and for the County of McPherson, State of Kansas, this 28th day of October, 1964

My Commission expires: December 23, 1967

Francis D. Melland
Notary Public