


STATE CORPORATION COMMISSION

Give Information Completely  
 Make Required Affidavit  
 Mail or Deliver Report to:  
 Conservation Division  
 State Corporation Commission  
 211 No. Broadway  
 Wichita, Kansas

15-169-00248-00-00  
**WELL PLUGGING RECORD**

NORTH

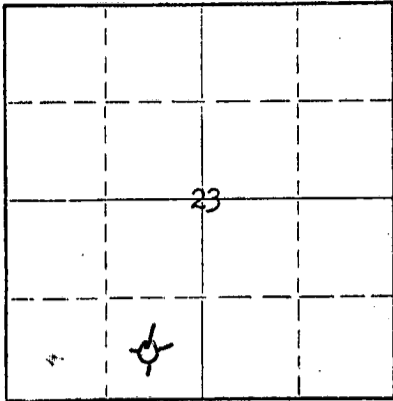

Locate well correctly on above Section Plat

Saline County. Sec. 23 Twp. 15 Rge. (E) 2 (W)  
 Location as "NE/CNW/SW" or footage from lines Center SE/4 SW/4  
 Lease Owner Dale Reese Oil Company  
 Lease Name Hubbard Well No. 1  
 Office Address 139 No. Santa Fe, Salina, Kansas  
 Character of Well (completed as Oil, Gas or Dry Hole) Dry Hole  
 Date well completed March 31, 1963  
 Application for plugging filed March 31, 1963  
 Application for plugging approved 19  
 Plugging commenced March 31, 1963  
 Plugging completed March 31, 1963  
 Reason for abandonment of well or producing formation Dry Hole

If a producing well is abandoned, date of last production 19  
 Was permission obtained from the Conservation Division or its agents before plugging was commenced? Yes

Name of Conservation Agent who supervised plugging of this well Cecil Jones  
 Producing formation \_\_\_\_\_ Depth to top \_\_\_\_\_ Bottom \_\_\_\_\_ Total Depth of Well 2758 Feet  
 Show depth and thickness of all water, oil and gas formations.

OIL, GAS OR WATER RECORDS

CASING RECORD

FORMATION	CONTENT	FROM	TO	SIZE	PUT IN	PULLED OUT
				8-5/8"	141'	None

Describe in detail the manner in which the well was plugged, indicating where the mud fluid was placed and the method or methods used in introducing it into the hole. If cement or other plugs were used, state the character of same and depth placed, from \_\_\_\_\_ feet to \_\_\_\_\_ feet for each plug set.

2758' to 140' - Heavy Mud  
 140' - Rock Bridge  
 140' to 80' - 20 Sacks of Cement  
 80' to 30' - Heavy Mud  
 30' - Rock Bridge  
 30' to 5' - 8 Sacks of Cement  
 5' to 0' - Surface Soil

**RECEIVED**  
 STATE CORPORATION COMMISSION

APR 25 1963

CONSERVATION DIV.  
 Wichita, Kansas

(If additional description is necessary, use BACK of this sheet)

Name of Plugging Contractor Melland Drilling Company, Inc.  
 Address 1111 North Main Street, Hutchinson, Kansas

STATE OF Kansas, COUNTY OF Saline, ss.  
 Dale Reese (employee of owner) or (owner or operator) of the above-described well, being first duly sworn on oath, says: That I have knowledge of the facts, statements, and matters herein contained and the log of the above-described well as filed and that the same are true and correct. So help me God.

(Signature) Dale Reese

139 N. Santa Fe, Salina, Kansas  
 (Address)

SUBSCRIBED AND SWORN TO before me this 24th. day of April, 1963

My commission expires 6-8-65

*Clara L. Young*  
 Notary Public.

**INVOICED**

DATE 4/26/63  
 INV. NO. 6992-W

WELL RECORD

15-169-00248-00-00

LEASER: Hubbard

WELL NO. 1

LOCATION: Center SE/4 SW/4  
Section 23-15S-2W  
Saline County, Kansas

COMMANDED: 3/26/63

COMPLETED: 3/31/63  
(rotary)

OPERATOR: Dale Reese Oil Company  
139 North Santa Fe  
Salina, Kansas

CONTRACTOR: Halland Drilling Company, Inc.  
111 North Main Street  
Hutchinson, Kansas

CASING RECORD: 8-5/8" OD at 141' with 100 sacks of cement and 2 1/2% calcium chloride.

FORMATION

LOG

Surface soil, clay & shale	120
Anhydrite	141
Anhydrite shale	217
Lime & shale	1239
Shale & shells	1670
Lime & shale	2490
Shale & lime	2693
Lime & shale	2758

TOTAL DEPTH  
PB w/ heavy mud from 2758' to 140',  
crushed rock bridge at 140', 20  
sacks of cement from 140' to 80',  
heavy mud from 80' to 30', crushed  
rock bridge at 30', 8 sacks of  
cement to 5', surface soil from 5'  
to 0'. Plugged and abandoned  
3-31-63

RECEIVED  
STATE CORPORATION COMMISSION

APR 25 1963

CONSERVATION DIVISION  
Wichita, Kansas