15-169-19053-00-00


STATE OF KANSAS
STATE CORPORATION COMMISSION

Form CP-4

Give All Information Completely
Make Required Affidavit
Mail or Deliver Report to:
Conservation Division
State Corporation Commission
211 No. Broadway
Wichita, Kansas

WELL PLUGGING RECORD

NORTH

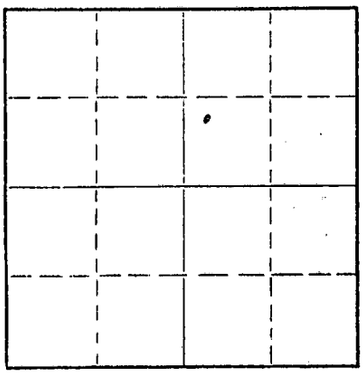

Locate well correctly on above Section Plat

Saline County. Sec. 18 Twp. 15 Rge. (E) 2 (W)

Location as "NE/CNW¼SW¼" or footage from lines NW SW NE

Lease Owner E. H. Riggs

Lease Name Jilka Well No. 2

Office Address 1107 Union National Building, Wichita 2, Kansas

Character of Well (completed as Oil, Gas or Dry Hole) oil

Date well completed 19

Application for plugging filed July 26 1963

Application for plugging approved 19

Plugging commenced July 26 1963

Plugging completed August 19 1963

Reason for abandonment of well or producing formation depleted

If a producing well is abandoned, date of last production 6-1 1963

Was permission obtained from the Conservation Division or its agents before plugging was commenced? yes

Name of Conservation Agent who supervised plugging of this well Gilbert J. Toman

Producing formation Depth to top Bottom Total Depth of Well 3249 Feet

Show depth and thickness of all water, oil and gas formations.

OIL, GAS OR WATER RECORDS — CASING RECORD

FORMATION	CONTENT	FROM	TO	SIZE	PUT IN	PULLED OUT
		0	280	8 5/8"	280	none
		0	3244	5½	3244	2738.86

Describe in detail the manner in which the well was plugged, indicating where the mud fluid was placed and the method or methods used in introducing it into the hole. If cement or other plugs were used, state the character of same and depth placed, from feet to feet for each plug set.

Pushed plug to 3235', set 10' rock bridge and dumped 5 sacks of cement.

Bailed hole down to 275', build bridge to 250'. Dump 3 yards of redi-mix concrete. Hole plugged 5 p.m.

RECEIVED
STATE CORPORATION COMMISSION
SEP 27 1963
CONSERVATION DIVISION
Wichita, Kansas

(If additional description is necessary, use BACK of this sheet)

Name of Plugging Contractor Pipe Pullers, Inc.

Address Box 486, Ellinwood, Kansas

STATE OF Kansas, COUNTY OF Barton, ss.

Dean Wells (employee of owner) or (~~owner or operator~~) of the above-described well, being first duly sworn on oath, says: That I have knowledge of the facts, statements, and matters herein contained and the log of the above-described well as filed and that the same are true and correct. So help me God.

(Signature) Dean Wells

Ellinwood, Kansas
(Address)

SUBSCRIBED AND SWORN TO before me this 23rd day of August, 1963

Georgia Meyer
Notary Public.

My commission expires ~~July 7, 1964~~ Feb. 10, 1967

15-169-19053-00-00


KANSAS GEOLOGICAL SOCIETY
KANSAS WELL LOG BUREAU — KANSAS WELL SAMPLE BUREAU
KANSAS GEOLOGICAL SOCIETY BUILDING
508 EAST MURDOCK - WICHITA, KANSAS

COMPANY E. H. Riggs

FARM Jilka NO. 2

SEC. 18 T. 15 R. 2W
LOC. NW SW NE

COUNTY Saline
KANSAS

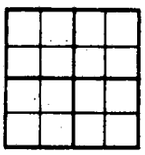

TOTAL DEPTH 3249'
COMM. 1-10-62 COMP. 1-20-62
SHOT OR TREATED
CONTRACTOR
ISSUED SeRoBee Drilling Co., Inc.

CASING

20	10		
15	8	5/8"	280' W/250 sacks
12	6		
13	5	1/2"	3244' W/75 sacks

ELEVATION 1251 GL

PRODUCTION

FIGURES INDICATE BOTTOM OF FORMATIONS

0	-	90	Shale & sand
90	-	190	Lime & shale
190	-	240	Lime
240	-	2804	Lime & shale
2804	-	2920	Miss. Lime & chert
2920	-	2964	Shale & lime
2964	-	3140	Kinderhook shale
3140	-	3249	Lime & shale
		3249	TD

RECEIVED
STATE CORPORATION COMMISSION
JUL 29 1963
CONSERVATION DIVISION
Wichita, Kansas