


STATE OF KANSAS
STATE CORPORATION COMMISSION

Give All Information Completely
Make Required Affidavit
Mail or Deliver Report to:
Conservation Division
State Corporation Commission
800 Bittling Building
Wichita, Kansas

WELL PLUGGING RECORD

15-189-00070-00-00

NORTH

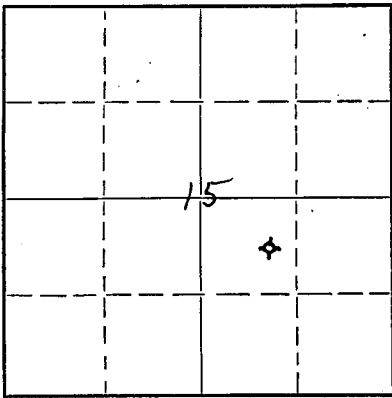

Locate well correctly on above
Section Plat

Saline County. Sec. 15 Twp. 15S Rge. (E) 2 (W)
Location as "NE/CNW $\frac{1}{4}$ SW $\frac{1}{4}$ " or footage from lines C E/2 NW/4 SE/4
Lease Owner Harper Well Service
Lease Name Ross Well No. 2
Office Address McPherson, Kansas
Character of Well (completed as Oil, Gas or Dry Hole) Dry Hole
Date well completed April 24, 1955
Application for plugging filed April 25, 1955
Application for plugging approved April 24, 1955
Plugging commenced April 24, 1955
Plugging completed April 24, 1955
Reason for abandonment of well or producing formation Dry Hole

If a producing well is abandoned, date of last production 19
Was permission obtained from the Conservation Division or its agents before plugging was commenced? Yes (Verbal)

Name of Conservation Agent who supervised plugging of this well Ruel Durkee
Producing formation None Depth to top Bottom Total Depth of Well 2836' Feet
Show depth and thickness of all water, oil and gas formations.

OIL, GAS OR WATER RECORDS

CASING RECORD

Formation	Content	From	To	Size	Put In	Pulled Out
Mississippi Lime	Dry			8-5/8"	152'	None

Describe in detail the manner in which the well was plugged, indicating where the mud fluid was placed and the method or methods used in introducing it into the hole. If cement or other plugs were used, state the character of same and depth placed, from feet to feet for each plug set.

Heavy Mud from 2836' to 148'
Set wood plug at 148'
15 sacks of cement from 148' to 100'
Heavy Mud from 100' to 30'
Set wood plug at 30'
5 sacks of cement from 30' to 5'
Surface soil from 5' to top

RECEIVED
STATE CORPORATION COMMISSION

MAY 10 1955

CONSERVATION DIVISION
WICHITA, KANSAS

(If additional description is necessary, use BACK of this sheet)

Name of Plugging Contractor J. A. Melland, Rotary Drilling Contractor
Address 1111 North Main Street, Hutchinson, Kansas

STATE OF Kansas, COUNTY OF Harney
Arthur L. Harper (employee of owner) or (owner or operator) of the above-described well,
being first duly sworn on oath, says: That I have knowledge of the facts, statements, and matters herein contained and the log of the above-described well as filed and that the same are true and correct. So help me God.

(Signature)

Arthur L. Harper
Box C Burdett, Kan.
(Address)

SUBSCRIBED AND SWORN to before me this 29th day of April, 1955

My commission expires April 15, 1957

23-8390-s 6-51-20M

Notary Public.

PLUGGING
FILE SEC 15 T 15 R 2W
BOOK PAGE 45 LINE 4

W E L L R E C O R D

15-169-00070-0000

LEASE NAME Ross WELL NO. 2 ELEVATION _____

LOCATION C E/2 NW/4 SE/4 Section 15-15S-2W, Saline County, Kansas

LEASE OWNER Harper Well Service, McPherson, Kansas

DATE STARTED April 16, 1955 DRILLING COMMENCED April 17, 1955

DRILLING COMPLETED April 24, 1955

DRILLING CONTRACTOR J. A. Melland, 1111 N. Main St., Hutchinson, Kansas

ROTARY DRILLING FROM 0 TO 2836'

FORMATION	FROM	TO	REMARKS
-----------	------	----	---------

Surface soil & clay	0	40	
Shale & shells	40	165	Set and cemented 8-5/8" OD casing at 152' with 100 sacks of cement. Cement circulated.
Shale	165	425	
Shale & lime	425	555	
Shale & shells	555	670	
Lime & shale	670	840	
Sandy shale & lime	840	1105	
Sandy shale & shells	1105	1425	
Shale & lime	1425	1740	
Lime with shale streaks	1740	1850	
Shale & lime	1850	1980	
Lime & shale	1980	2605	
Shale & lime	2605	2680	
Lime & shale	2680	2780	
Shale & lime	2780	2836	

			Circulated for samples @ 2800' - 50 min.
			Circulated for samples @ 2806' - 55 min.
			Circulated for samples @ 2813' - 55 min.
			Circulated for samples @ 2821' - 44 min.
			Circulated for samples @ 2831' - 47 min.
			Circulated @ 2836' WO orders - 52 min.
TOTAL DEPTH	2836		As all zones tested were found to be non-productive of oil or gas, the well was plugged and abandoned as follows: Heavy mud from 2836' to 148', set wood plug at 148', 15 sacks of cement from 148' to 100', heavy mud from 100' to 30', set wood plug at 30', 5 sacks of cement from 30' to 5', surface soil from 5' to top. Well plugging done under direction of Ruel Durkee, State Corporation Commission Well Plugger. Slope tests were taken at regular intervals and no deflections from vertical were recorded.

RECEIVED
STATE CORPORATION COMMISSION

MAY 10 1955

CONSERVATION DIVISION
Wichita, Kansas

PLUGGING
FILE SEC 15 T 15 R 2W
BOOK PAGE 115 LINE 4