


STATE OF KANSAS
STATE CORPORATION COMMISSION

Give All Information Completely
Make Required Affidavit
Mail or Deliver Report to:
Conservation Division
State Corporation Commission
800 Bittling Building
Wichita, Kansas

15-169-00089-00-00
WELL PLUGGING RECORD

NE NE NE
Saline County. Sec. 15 Twp. 15 Rge. 2 (E) W(W)

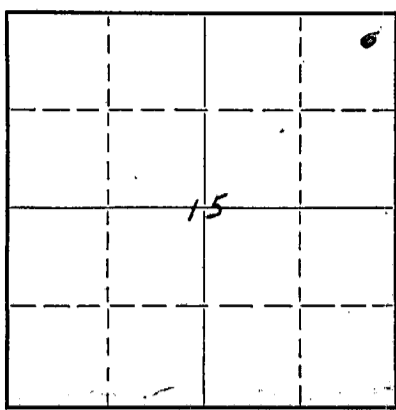

Locate well correctly on above Section Flat

Location as "NE/CNW 1/4 SW 1/4" or footage from lines
Lease Owner Harper Well Servicing et al
Lease Name Bachofer Well No. 1
Office Address Burrton, Kans.
Character of Well (completed as Oil, Gas or Dry Hole) dry hole
Date well completed April 20, 1951 19
Application for plugging filed April 21, 1951 19
Application for plugging approved May 1, 1951 19
Plugging commenced April 24, 1951 19
Plugging completed April 28, 1951 19
Reason for abandonment of well or producing formation water

If a producing well is abandoned, date of last production 19
Was permission obtained from the Conservation Division or its agents before plugging was commenced? yes

Name of Conservation Agent who supervised plugging of this well R. Durkee
Producing formation Mississippi Depth to top 2771' Bottom 2807' Total Depth of Well 2807 Feet
Show depth and thickness of all water, oil and gas formations.

OIL, GAS OR WATER RECORDS

CASING RECORD

Formation	Content	From	To	Size	Put In	Pulled Out

Describe in detail the manner in which the well was plugged, indicating where the mud fluid was placed and the method or methods used in introducing it into the hole. If cement or other plugs were used, state the character of same and depth placed, from feet to feet for each plug set.

Plugged back to 2798 with 450# lead wool. Filled to 2765 with cal seal & 9 sacks of cement. Hole mudded to 165' rock bridge and 15 sacks of cement. Mudded to 15' then dumped 5 sacks cement.

STATE OF KANSAS
MAY 11 1951
CONSERVATION DIVISION

(If additional description is necessary, use BACK of this sheet)
Correspondence regarding this well should be addressed to Harper Well Servicing
Address Burrton, Kans.

STATE OF Kansas, COUNTY OF Harvey, ss.
I, Arthur L. Harper ~~employee~~ or (owner & operator) of the above-described well,
being first duly sworn on oath, says: That I have knowledge of the facts, statements, and matters herein contained and the log of the above-described well as filed and that the same are true and correct. So help me God.

(Signature) Arthur L. Harper
Box C Burrton Kan
(Address)

SUBSCRIBED AND SWORN to before me this 8th day of May 1951

My commission expires March 26, 1952

Ralph E. Culogant
Notary Public

PLUGGING
FILE SEC 15 T 15 R 2W
BOOK PAGE 79 LINE 4

15-169-00089-00-00

Company: A. L. Harper
Farm: Bachofer

Sec 15, T15, R 2W
NE NE NE 1/4
Saline County, Kansas
Rotary Tools:
Elevation: 1333 DF
Rotary Total Depth: 2791'

Comm: March 19, 1951
Comp: March 29, 1951
Contractor: Penguin Petroleum, Inc.

Casing: 8 5/8" 179.66' @ cem w/125 sx.
5 1/2" 2791.77' @ cem w/35 sx.

0-40	Surface soil and sand.
-110	Rock, sand
-175	Rock, shale
-220	Clay & shale
-305	Anhydrite
-540	Shale & lime shells
-700	Lime & shale
-920	Lime
-990	Shale
-1040	Lime
-1180	Shale & lime
-1300	Lime & shale
-1385	Lime
-1410	Lime & shale
-1750	Shale & lime
-1775	Lime & shale
-1865	Lime
-2015	Lime & shale
-2149	Shale
-2304	Lime
-2544	Lime & shale
-2585	Lime
-2791	Lime & shale

Tops: Kansas City @ 2149'
Mississippi @ 2771'

Certified to be a true copy of the well log as indicated on daily drilling reports

PENGUIN PETROLEUM, INC.

By Don Milled

Subscribed and sworn to before me, the undersigned, a Notary Public in and for Sedgewick County, Kansas, this 29 day of April, 1951.

My Commission Expires:

October 15, 1952

S. D. Shuckland
Notary Public

PLUGGING
FILE SEC 15 T 15 R 2W
BOOK PAGE 79 LINE 4