


Give All Information Completely  
Make Required Affidavit  
Mail or Deliver Report to:  
Conservation Division  
State Corporation Commission  
211 No. Broadway  
Wichita, Kansas

WELL PLUGGING RECORD

NORTH

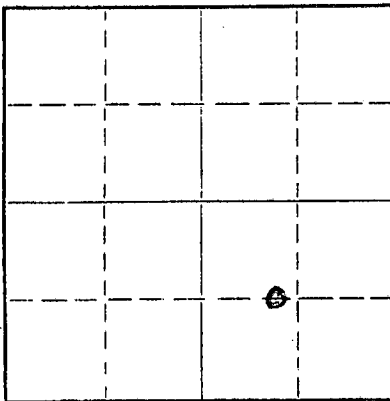

Locate well correctly on above  
Section Plat

Saline County. Sec. 14 Twp. 15 Rge. (E) 2 (W)  
Location as "NE/CNW/SW" or footage from lines E/2 W/2 SE  
Lease Owner Hollar Oil Co.  
Lease Name Ringquist Well No. 1  
Office Address Wichita, Kansas  
Character of Well (completed as Oil, Gas or Dry Hole) Dry Hole  
Date well completed June 12, 19 66  
Application for plugging filed " " 19 66  
Application for plugging approved " " 19 66  
Plugging commenced " " 19 66  
Plugging completed " " 19 66  
Reason for abandonment of well or producing formation dry hole

If a producing well is abandoned, date of last production 19  
Was permission obtained from the Conservation Division or its agents before plugging was commenced? yes

Name of Conservation Agent who supervised plugging of this well Toman  
Producing formation Depth to top Bottom Total Depth of Well 2767 Feet  
Show depth and thickness of all water, oil and gas formations.

OIL, GAS OR WATER RECORDS

CASING RECORD

FORMATION	CONTENT	FROM	TO	SIZE	PUT IN	PULLED OUT
				8 5/8	135	none

Describe in detail the manner in which the well was plugged, indicating where the mud fluid was placed and the method or methods used in introducing it into the hole. If cement or other plugs were used, state the character of same and depth placed, from feet to feet for each plug set.

Mud 2767' to 120'  
Wooden plug & 1/2sx hulls @ 120'  
20sx cement on plug  
Mud to 40'  
Wooden plug and 1/2sx hulls @ 40'  
10sx cement on plug  
surface soil to 0'  
2sx cement in rat hole

RECEIVED  
STATE CORPORATION COMMISSION

JUN 24 1966

CONSERVATION DIVISION  
Wichita, Kansas

(If additional description is necessary, use BACK of this sheet)

Name of Plugging Contractor Melland Drilling Co., Inc.  
Address Box 783 McPherson, Kansas

STATE OF Kansas, COUNTY OF McPherson, ss.  
Donald J. Melland (employee of owner) or ~~XXXXXX~~ of the above-described well, being first duly sworn on oath, says: That I have knowledge of the facts, statements, and matters herein contained and the log of the above-described well as filed and that the same are true and correct. So help me God.

(Signature) Donald J. Melland  
Box 783 McPherson, Kansas  
(Address)

Notary Public.

SUBSCRIBED AND SWORN to before me this 16th day of June, 19 66  
My commission expires December 23, 1966



15-169-30029-00-00

# WELL RECORD

LEASE: Ringquist

WELL NO. 1

ELEVATION: 1327 RB

LOCATION: E/2 W/2 SE  
Sec. 14-15-2W

COMMENCED: 6/6/66

COMPLETED: 6/12/66

OPERATOR: Hollar Oil Co.

CONTRACTOR: Melland Drilling Company, Inc.  
Post Office Box 783  
McPherson, Kansas

CASING RECORD: 8 5/8" @ 135'/90sx

FORMATION	LOG
clay & shale	95
anhydrite	287
lime & shale	1215
shale & lime	1520
lime & shale	2767
RTD	2767

## Sample Tops

Lansing	2126
Mississippi Lime	2757
Mississippi Dolomite	2763

DST #1, 2727-2767, open 1 hr.  
rec. 118' very sli. oil cut mud,  
BHF 588-549, FF 26-78

**RECEIVED**  
STATE CORPORATION COMMISSION

JUN 24 1966

CONSERVATION DIVISION  
Wichita, Kansas

## CERTIFICATE

State of Kansas, County of McPherson, ss.

I, Donald J. Melland, do hereby certify that the above is a true and correct copy of the log of the above named and described well, as reflected by the records of the Melland Drilling Company, Inc.

*Donald J. Melland*

Subscribed and sworn to before me, a Notary Public, in and for the County of McPherson, State of Kansas, this 10th day of June, 1966.

My Commission expires: December 23, 1967

*James P. [Signature]*  
Notary Public