


15-189-00209-00-00

WELL PLUGGING RECORD

Give All Information Completely
Make Required Affidavit
Mail or Deliver Report to:
Conservation Division
State Corporation Commission
211 No. Broadway
Wichita, Kansas

Saline County. Sec. 8 Twp. 15 Rge. (E) 2 (W) 2
Location as "NE/CNWxSWx" or footage from lines C NW NW SE
Lease Owner James E. Kovanda, et al
Lease Name Romeiser Well No. 1
Office Address Box 368, Salina, Kansas
Character of Well (completed as Oil, Gas or Dry Hole) Dry Hole
Date well completed October 2, 1961
Application for plugging filed October 2, 1961
Application for plugging approved October 2, 1961
Plugging commenced October 2, 1961
Plugging completed October 2, 1961
Reason for abandonment of well or producing formation dry

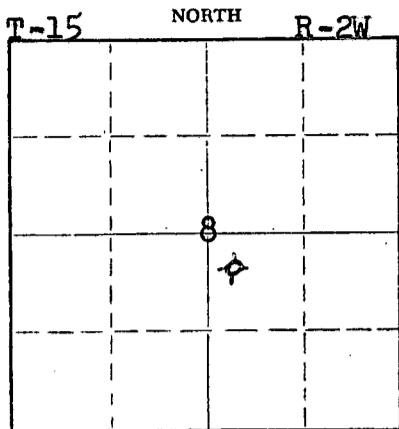

Locate well correctly on above
Section Plat

If a producing well is abandoned, date of last production _____ 19____
Was permission obtained from the Conservation Division or its agents before plugging was commenced? Yes

Name of Conservation Agent who supervised plugging of this well Cecil Jones, McPherson, Kansas
Producing formation _____ Depth to top _____ Bottom _____ Total Depth of Well 3368 Feet
Show depth and thickness of all water, oil and gas formations.

OIL, GAS OR WATER RECORDS

CASING RECORD

FORMATION	CONTENT	FROM	TO	SIZE	PUT IN	PULLED OUT
				8 5/8"	264'	None

Describe in detail the manner in which the well was plugged, indicating where the mud fluid was placed and the method or methods used in introducing it into the hole. If cement or other plugs were used, state the character of same and depth placed, from _____ feet to _____ feet for each plug set.

Mud up to 240 feet, set plug, then one-half sack Hulls and 20 sacks cement. Top plug at 35 feet, one-quarter sack Hulls and 8 sacks cement - 2 sacks cement in rathole.

STATE CORPORATION COMMISSION

OCT 5 1961

CONSERVATION DIVISION
WICHITA, KANSAS

(If additional description is necessary, use BACK of this sheet)

Name of Plugging Contractor Donald T. Ingling
Address 615 First National Bldg., Wichita 2, Kansas

STATE OF KANSAS, COUNTY OF SEDGWICK, ss.
D. T. Ingling (employee of owner) or (owner or operator) of the above-described well, being first duly sworn on oath, says: That I have knowledge of the facts, statements, and matters herein contained and the log of the above-described well as filed and that the same are true and correct. So help me God.

(Signature) [Signature]
615 First National Bldg., Wichita 2
(Address)

SUBSCRIBED AND SWORN to before me this 4th day of October, 1961



[Signature]
Notary Public.



James E. Kovanda, et al, Lease Owner

Section 8-15-2W

Donald T. Ingling, Contractor

Location: C NW NW SE

Commenced: September 22, 1961

County: Saline

Completed: October 2, 1961

Production: dry

Total Depth: 3368'

Elevation: 1288 RB

Casing: 8 5/8" 264' (160 sacks cement)

Figures below indicate bottom formation

200 surface clay, shale and shells
 264 lime
 690 lime
 850 lime and shale
 1265 shale and shells
 1460 shale and shells
 1655 shale and lime
 1810 lime and shale streaks
 1950 lime
 2170 shale and sand
 2310 lime
 2415 lime
 2520 lime
 2590 shale and shells
 2730 shale and lime
 2771 shale
 2820 Mississippi
 2885 Mississippi
 2985 Mississippi
 3012 Mississippi
 3035 shale
 3120 shale
 3174 shale
 3210 lime
 3259 lime
 3265 shale
 3320 shale
 3358 shale
 3368 Maquoketa dolomite
 3368 Total Depth

I certify this is a true and correct copy of the above mentioned well.

D. T. Ingling

STATE OF KANSAS, COUNTY OF SEDGWICK: ss.

Subscribed and sworn to before me, a Notary Public, in said county and state.

W. E. Black
Notary Public

My commission expires: Feb. 27, 1964