

15-1169-00963-0000
WELL PLUGGING RECORD

Give All Information Completely
Make Required Affidavit
Mail or Deliver Report to:
Conservation Division
State Corporation Commission
800 Bitting Building
Wichita, Kansas

FORMATION PLUGGING RECORD

Strike out upper line when reporting plugging off formations.

NORTH

330

34

**Locate well correctly on above
Section Plat**

Saline County. Sec. 34 Twp. 15 Rge. (E) 4 (W)
Location as "NE $\frac{1}{4}$ NW $\frac{1}{4}$ SW $\frac{1}{4}$ " or footage from lines 330' from Elms 330' ft from W. line
Lease Owner Herndon, Dr I G. Co.
Lease Name Lindsfield Well No. 1
Office Address Box 1565 Tulsa OKla.
Character of Well (completed as Oil, Gas or Dry Hole) Dry hole
Date well completed 2-7-1943
Application for plugging filed 2-7-1943
Application for plugging approved 2-7-1943
Plugging commenced 2-9-1943
Plugging completed 2-9-1943
Reason for abandonment of well or producing formation Dry hole

If a producing well is abandoned, date of last production.....19.....
Was permission obtained from the Conservation Division or its agents before plugging was com-
menced?.....*yes*.....

Name of Conservation Agent who supervised plugging of this well. Russell Durkin
Producing formation. _____ Depth to top. _____ Bottom. _____ Total Depth of Well. 3506 Feet
Show depth and thickness of all water, oil and gas formations.



OIL, GAS OR WATER RECORDS

CASING RECORD

[illegible]

Describe in detail the manner in which the well was plugged, indicating where the mud fluid was placed and the method or methods used in introducing it into the hold. If cement or other plugs were used, state the character of same and depth placed, fromfeet tofeet for each plug set.

Hole filled with Mud to 153' hole
Drilled at 133'. 25 sacks of Cement placed on Driller
hole filled with Mud to 6' below Collar and filled
with Cement to bottom of Collar

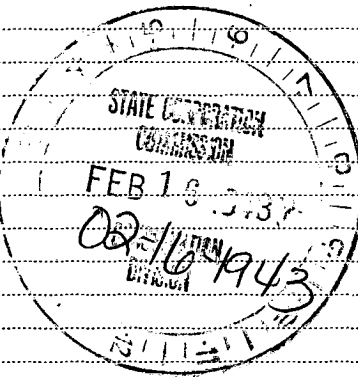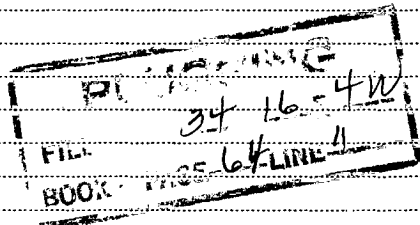

(If additional description is necessary, use BACK of this sheet)

Correspondence regarding this well should be addressed to: Stanley S. Stryker, Co
Address: Box 1565 Tulsa Oklahoma

STATE OF Oklahoma, COUNTY OF LeFlore, ss.
W. S. Prather (employee of owner) or (owner or operator) of the above-described well,
 being first duly sworn on oath, says: That I have knowledge of the facts, statements, and matters herein contained and the log of the above-described well as filed and that the same are true and correct. So help me God.

(Signature)

(Address)

SUBSCRIBED AND SWORN to before me this 15 day of February, 1943

My commission expires.

Nov 30 - 1944

19-4174



6-42-6M

.....
Notary Public.

15-169-00963-00-00



Well Log of Linshield #1

Date spudded: January 16, 1943
 Date set casing:
 Date completed: February 9, 1943

Loc: 34-16-4W,
 Saline Co., Kansas
 Herndon Drilling Co.

Total depth: 3906'

From	To	Formation	Remarks
0	158	Shale & shells	Ran 153' of 13" OD Casing
158	186	Shale & shells	Used 150 sacks of cement
186	280	Shale & shells	
280	555	Shale & shells	
555	570	Lime	
570	605	Shale & shells	
605	650	Lime	
650	840	Lime & shale	
840	1010	Lime & shale	
1010	1170	Lime & shale	
1170	1270	Lime & shale	
1270	1315	Shale	
1315	1475	Shale & lime	
1475	1640	Shale & shells	
1640	1780	Shale & shells	
1780	1855	Shale & shells	
1855	1945	Shale & shells	
1945	2080	Shale & shells	
2080	2160	Shale & shells	
2160	2200	Shale & lime	
2200	2310	Shale & lime	
2310	2440	Shale & lime	
2440	2505	Lime	
2505	2580	Shale & lime	
2580	2665	Shale & lime	
2665	2680	Lime	
2680	2740	Lime & shale	
2740	2790	Lime & shale	
2790	2835	Lime & shale	
2835	2900	Shale & lime	
2900	2920	Lime	
2920	2930	Shale & lime	
2930	2980	Shale & lime	
2980	3045	Shale	
3045	3056	Shale	
3056	3120	Shale	
3120	3177	Shale	
3177	3185	Chat	
3185	3255	Lime	
3255	3335	Chat	
3335	3375	Chat	
3375	3410	Lime & chat	
3410	3460	Lime	
3460	3515	Shale & lime	
3515	3540	Shale	
3540	3625	Shale	
3625	3695	Lime & chat	
3695	3720	Lime	
3720	3765	Lime	
3765	3790	Lime	
3790	3845	Sand & shale	
3845	3871	Sand	
3871	3890	Siliceous Lime	
3890	3906	Lime	

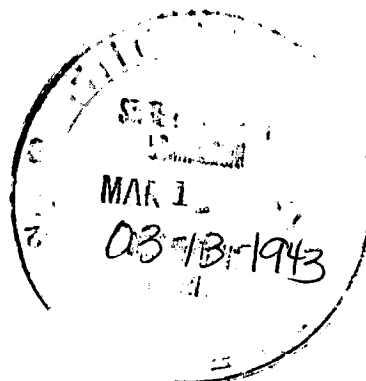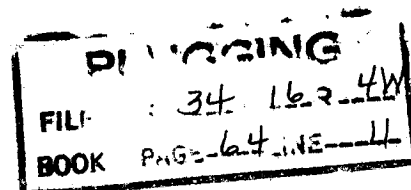

Subscribed & sworn to before me this 13
 day of March, 1943.

Mary Ramon
 Notary Public

My commission expires Nov. 30, 1944

I hereby certify the foregoing
 to be a true and correct copy of the
 original driller's log on the Lin-
 shield #1

Colene Little