

STATE OF KANSAS
STATE CORPORATION COMMISSION


Give all Information Completely
Make Required Affidavit
Mail or Deliver Report to:
Conservation Division
State Corporation Commission
212 North Market, Insurance Bldg.
Wichita, Kansas

WELL PLUGGING RECORD

Kingman County. Sec. 28 Twp. 30S Rge. XX 7 (W)

Location as "NE/CNW/SE" or footage from lines SE SE NW
Lease Owner Peel-Hardman Oil Operators
Lease Name Wells Well No. 1
Office Address R. R. #3, Box 144B, Wichita 20, Kansas
Character of Well (completed as Oil, Gas or Dry Hole) Dry Hole
Date well completed 9-17 19 60
Application for plugging filed 9-17 19 60
Application for plugging approved 9-17 19 60
Plugging commenced 9-17 19 60
Plugging completed 9-17 19 60
Reason for abandonment of well or producing formation Dry Hole

NORTH

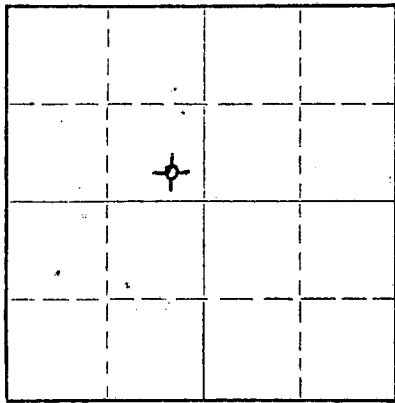

Locate well correctly on above Section Plat

If a producing well is abandoned, date of last production 19
Was permission obtained from the Conservation Division or its agents before plugging was commenced? Yes

Name of Conservation Agent who supervised plugging of this well Fred W. Hampel
Producing formation _____ Depth to top _____ Bottom _____ Total Depth of Well 4748 Feet
Show depth and thickness of all water, oil and gas formations.

OIL, GAS OR WATER RECORDS

CASING RECORD

FORMATION	CONTENT	FROM	TO	SIZE	PUT IN	PULLED OUT
		0	250'	8 5/8"	250'	None

Describe in detail the manner in which the well was plugged, indicating where the mud fluid was placed and the method or methods used in introducing it into the hole. If cement or other plugs were used, state the character of same and depth placed, from _____ feet to _____ feet for each plug set.


- From 4748' to 241 1/2' - Heavy Rotary Mud.
- " 241 1/2' to 240' - Wooden Plug.
- " 240' to 194' - 15 sacks cement & 1/2 sack hulls.
- " 194' to 36 1/2' - Heavy Rotary Mud.
- " 36 1/2' to 35' - Wooden Plug.
- " 35' to 6' - 10 sacks cement & 1/2 sack hulls.
- " 6' to surface - cellar.

RECEIVED
STATE CORPORATION COMMISSION
OCT 10 1960
CONSERVATION DIVISION
Wichita, Kansas

(If additional description is necessary, use BACK of this sheet)

Name of Plugging Contractor _____
Address _____

STATE OF KANSAS, COUNTY OF SEDGWICK, ss.
Wm. Herbert (employee of owner) or (owner or operator) of the above-described well, being first duly sworn on oath, says: That I have knowledge of the facts, statements, and matters herein contained and the log of the above-described well as filed and that the same are true and correct. So help me God.

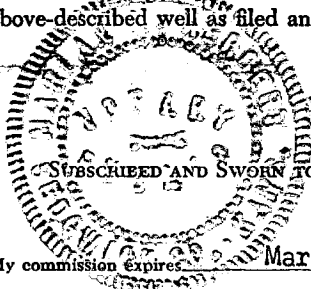

(Signature) Wm. Herbert
R. R. #3, Box 144B, Wichita 20, Kansas (Address)

SUBSCRIBED AND SWORN TO before me this 7th day of October, 19 60
My commission expires March 4, 1962
Manian M. Herbert Notary Public.

DRILLER'S LOG

Company: Peel-Hardman Oil Operators

Location: SE SE NW
Sec. 28-30S-7W

Farm: Wells Well No. 1

County: Kingman,
Kansas

Total Depth: 4748'

Comm.: 8-31-60 Comp.: 9-17-60

Contractor: Glenn W. Peel Drilling Company

Elevation:

Casing: 8 5/8" @ 250' cem.

Production: Dry

Figures below indicate bottom of formation

Surface Clay	0 -	30*
Sand		80
Shale		250
Shale & red bed		650
Shale & shells		1040
Shale w/Anhydrite streaks		1190
Broken lime & shale		1400
Lime		1695
Lime & shale		2125
Shale w/lime streaks		2925
Lime		3190
Lime & shale		3300
Lime		3495
Lime & shale		3625
Lime		3700
Lime & shale		3790
Lime		4170
Lime & shale		4227
Lime		4310
Lime & shale		4334
Lime & chert		4345
Lime		4380
Lime & chert		4460
Lime		4500
Lime & shale		4517
Lime		4555
Lime & shale		4733
Lime, shale & sand		4747
Sand		4748
Total Depth		4748

RECEIVED
STATE CORPORATION COMMISSION

OCT 10 1960

CONSERVATION DIVISION
Wichita, Kansas

This is to certify that the above information is to the best of my knowledge true and correct.

GLENN W. PEEL DRILLING COMPANY

BY: *Wm Herbert*

SUBSCRIBED AND SWORN TO before me this 7th day of October, 1960.

My commission expires March 4, 1962.

Marian M. Herbert
Notary Public

