


WELL PLUGGING RECORD

Give All Information Completely  
Make Required Affidavit  
Mail or Deliver Report to:  
Conservation Division  
State Corporation Commission  
800 Bitting Building  
Wichita, Kansas

Harper County, Sec. 14 Twp. 32 Rge. (E) 7 (W)

Location as "NE/CNW/SW" or footage from lines NW NW NE  
Lease Owner Musgrove Petroleum Corporation,  
Lease Name BEBERMEYER Well No. 1  
Office Address 518 Petroleum Building, Wichita, Ks.  
Character of Well (completed as Oil, Gas or Dry Hole) Dry hole  
Date well completed December 11, 19 54  
Application for plugging filed verbally December 11, 19 54  
Application for plugging approved verbally December 11, 19 54  
Plugging commenced December 11, 19 54  
Plugging completed December 11, 19 54  
Reason for abandonment of well or producing formation Dry hole

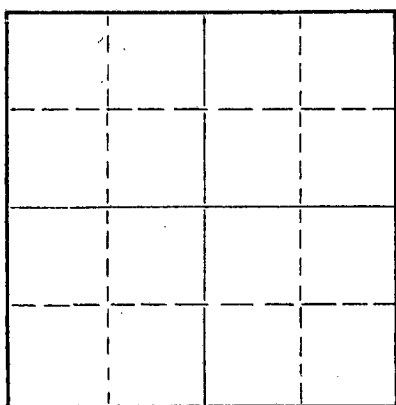

Locate well correctly on above Section Plat

If a producing well is abandoned, date of last production 19  
Was permission obtained from the Conservation Division or its agents before plugging was commenced? verbally - yes.

Name of Conservation Agent who supervised plugging of this well  
Producing formation Depth to top Bottom Total Depth of Well 4900' Feet  
Show depth and thickness of all water, oil and gas formations.

OIL, GAS OR WATER RECORDS

CASING RECORD

FORMATION	CONTENT	FROM	TO	SIZE	PUT IN	PULLED OUT
				8-5/8"	218'	

Describe in detail the manner in which the well was plugged, indicating where the mud fluid was placed and the method or methods used in introducing it into the hole. If cement or other plugs were used, state the character of same and depth placed, from feet to feet for each plug set.

Filled hole with heavy mud to 215'.  
Set first plug at 215' with 15 sx cement.  
Filled hole with mud to 15'.  
Set second plug at 15' with 5 sx cement.

(If additional description is necessary, use BACK of this sheet)  
Name of Plugging Contractor Musgrove Petroleum Corporation,  
Address 518 Petroleum Building, Wichita, Kansas.

STATE OF Kansas, COUNTY OF Kansas  
I, Gordon L. Koelling, (employee of owner) or (owner/operator) of the above-described well, being first duly sworn on oath, says: That I have knowledge of the facts, statements, and matters herein contained and the log of the above-described well as filed and that the same are true and correct. So help me God.

(Signature) *Gordon L. Koelling*  
518 Petroleum Building, Wichita, Kansas.  
(Address)

SUBSCRIBED AND SWORN to before me this 15th day of December 19 54  
My commission expires July 16, 1955.

*Arthur E. Rose*  
Notary Public.



**PLUGGING**  
BOOK PAGE 15 LINE 28  
SEC 14 T 32 R 7W

12-20-54  
DIVISION  
30500

CONTRACTOR'S WELL LOG

COMPANY: Musgrove Petroleum Corporation  
 CONTRACTOR: Musgrove Petroleum Corporation  
 FARM: Bebermeyer #1  
 LOCATION: NW NW NE Sec. 14-32-7  
 Harper County, Kansas.  
 COMMENCED: November 21, 1954  
 COMPLETED: December 11, 1954

0	5	Clay
5	50	Sand
50	230	Red bed
230	540	Red bed & shale
540	1114	Shale
1114	1150	Anhydrite
1150	1555	Shale & shells
1555	3260	Shale & lime
3260	3361	Shale & sand
3361	3515	Sand, shale & lime
3515	3596	Sand & shale
3596	3693	Sand, shale & chert
3693	3770	Sandy shale & lime
3770	3872	Lime & shale
3872	4054	Lime
4054	4360	Lime & shale
4360	4380	Lime
4380	4443	Mississippi
4443	4540	Mississippi lime
4540	4732	Lime
4732	4793	Simpson
4793	4812	Sand & shale
4812	4882	Shale
4882	4900	Arbuckle
	4900	Rotary Total Depth

Set 8-5/8" surface pipe at 218' with 150 sacks cement & 3 calcium chloride.

Dry and Abandoned.

STATE OF KANSAS        )  
                               )) SS  
 COUNTY OF SEDGWICK    )

I, Gordon L. Koelling, do hereby certify that the above and foregoing is a true and correct copy of the log of the BEBERMEYER #1 NW NW NE, Section 14-32-7, Harper County, Kansas, as reflected by the files of the Musgrove Petroleum Corporation.

MUSGROVE PETROLEUM CORPORATION

BY Gordon L. Koelling  
 Secretary-Treasurer

Subscribed and sworn to before me, a Notary Public, in and for Sedgwick County, Kansas, this 15th day of December, 1954.

Alma E. Ross  
 Notary Public

My commission expires July 16, 1955.

**PLUGGING**  
 FILE DEC 14 1954  
 BOOK PAGE 15 LINE 28