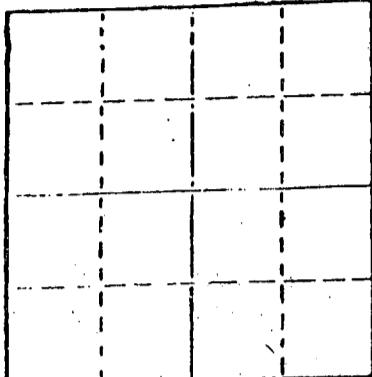


STATE OF KANSAS  
STATE CORPORATION COMMISSION

Give All Information Completely  
Make Required Affidavit  
Mail or Deliver Report to  
Conservation Division  
State Corporation Comm.  
245 North Water  
Wichita, KS 67202

Locate well correctly on above  
Section Plot

## WELL PLUGGING RECORD

Well full  
15-007-20080-0000

BARBER County. Sec. 25 Twp. 33 Rge. 10 E/W  
Location as "NE/CNW SW" or footage from lines

SW NE SW

Lease Owner TEXAS OIL AND GAS CORPORATION

Lease Name FRISBIE Well No. 1

Office Address 200 W Douglas, 300 Suite, Wichita

Character of Well (Completed as Oil, Gas or Dry Hole)

DRY

Date Well completed 4-10 19 79

Application for plugging filed 5-18 19 79

Application for plugging approved 5-20 19 79

Plugging commenced 6-16 19 79

Plugging completed 6-19 19 79

Reason for abandonment of well or producing formation

DRY

If a producing well is abandoned, date of last production 19

Was permission obtained from the Conservation Division or  
its agents before plugging was commenced? YES

Name of Conservation Agent who supervised plugging of this well BILL OWENS  
Producing formation Depth to top Bottom Total Depth of Well 45-15  
Show depth and thickness of all water, oil and gas formations.

## OIL, GAS OR WATER RECORDS

## CASING RECORD

FORMATION	CONTENT	FROM	TO	SIZE	PUT IN	PULLED OUT
				8 5/8	214	NONE
				4 1/2"	4514	2275

Describe in detail the manner in which the well was plugged, indicating where the mud fluid was placed and the method or methods used in introducing it into the hole. If cement or other plugs were used, state the character of same and depth placed, from \_\_\_\_\_ feet to \_\_\_\_\_ feet for each plug set.

SAND UP TO 2500. 4 SACKS CEMENT from 2500, 2460. WOOD BRIDGE AT 214,  
ROCKS 210. 4 YARDS READY MIX.

RECEIVED  
STATE CORPORATION COMMISSION

NOV 08 1979


CONSERVATION DIVISION  
Wichita, Kansas

(If additional description is necessary, use BACK of this sheet)

Name of Plugging Contractor CLARKE CORPORATION

STATE OF Kansas COUNTY OF Barker, ss.  
Elmo R. Morgenstern (employee of owner) or (owner or operator)  
of the above-described well, being first duly sworn on oath, says: That I have knowledge of  
the facts, statements, and matters herein contained and the log of the above-described well  
as filed and that the same are true and correct. So help me God.

(Signature) Elmo R. Morgenstern  
(Address) Medicine Lodge, Ks.

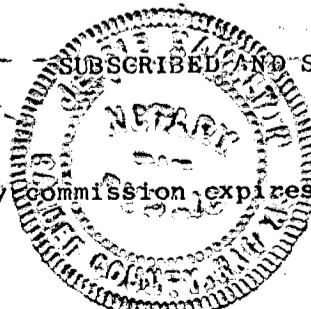
SUBSCRIBED AND SWORN TO before me this 10th day of November, 1979.Jessie Hamilton  
Notary Public.My commission expires April 4, 1982.

WELL : FRISBIE #1

LOCATION : SW NE SW SEC. 25-33S-10 W

15-007-204696-  
000

ELEVATION : 1367' G.L. 1378' K.B.

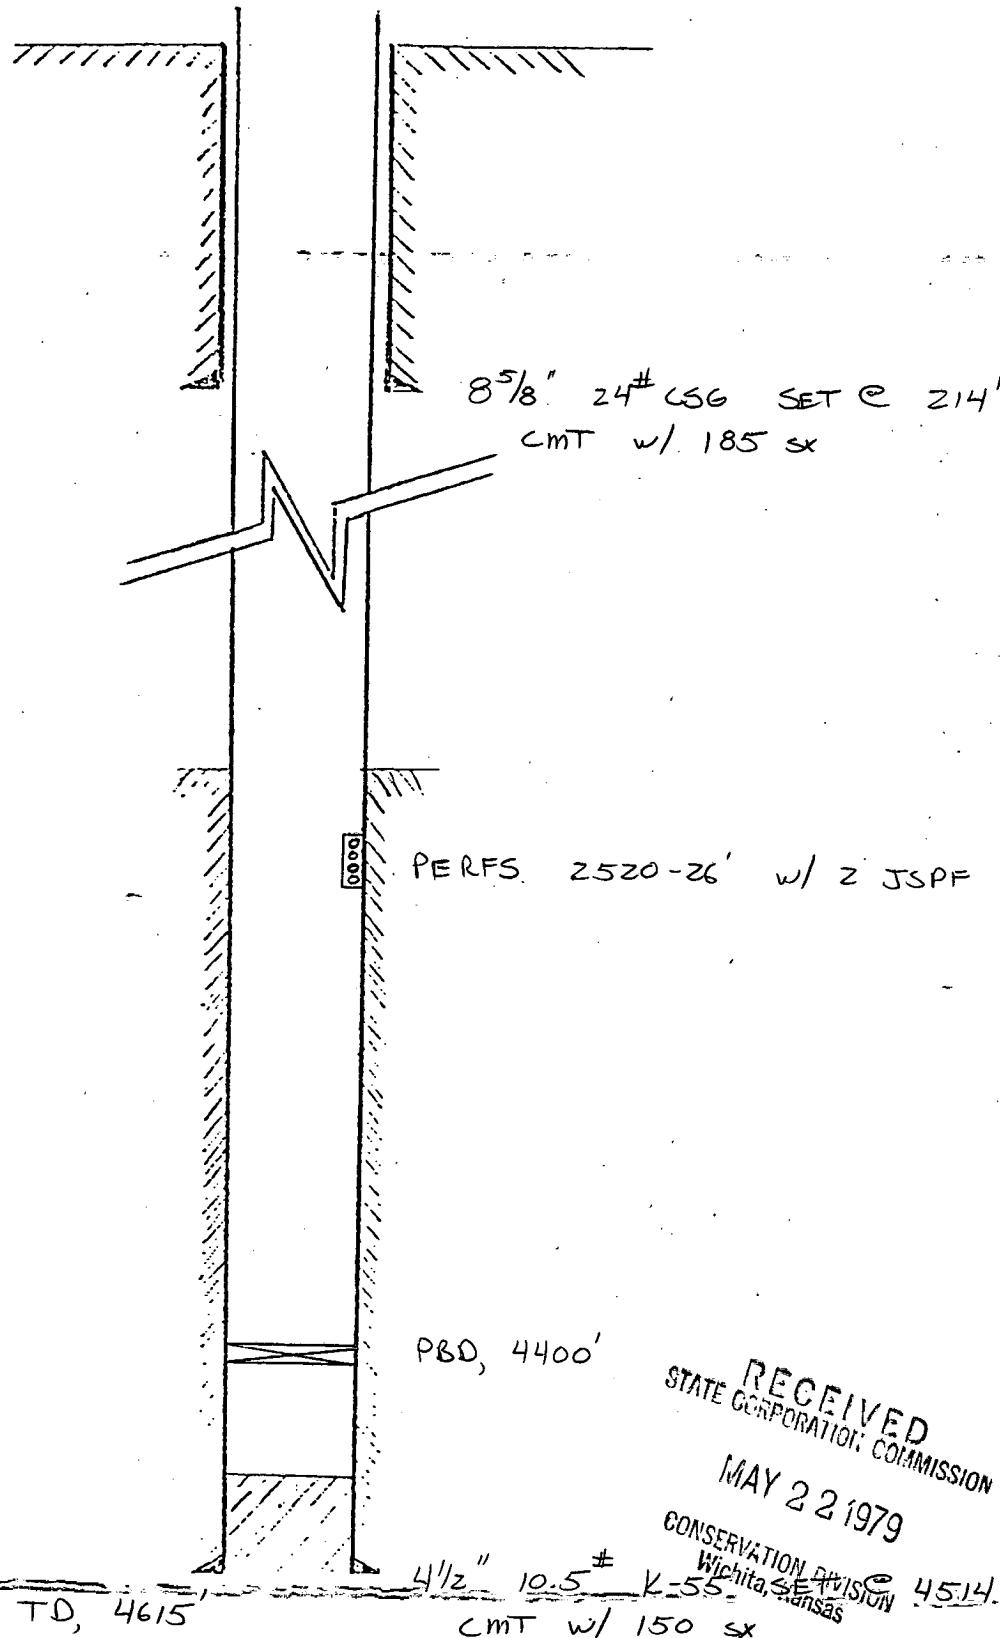

## ROTARY DRILLERS LOG

15-007-200916-0000

OPERATOR: National Oil Company DRILLING COMMENCED: February 21, 1979  
 200 West Douglas--Suite 550  
 Wichita, Kansas 67202

CONTRACTOR: Graves Drilling Co., Inc. DRILLING COMPLETED: March 4, 1979  
 910 Union Center  
 Wichita, Kansas 67202

CASING RECORD: 5 Jts. 214' of new 8-5/8" LOCATION: FRISBIE NO. 1  
 cemented with 185 sacks SW NE SW  
 112 Jts. 4514' of new 4-1/2" Section 25-33S-10W  
 cemented with 150 sacks Barber County, Kansas

0 - 214 Red Bed and Red Rock  
 214 - 691 Red Bed and Shale  
 691 - 1525 Shale  
 1525 - 3515 Shale and Lime  
 3515 - 3710 Lime and Shale  
 3710 - 4333 Shale and Lime  
 4333 - 4600 Lime and Shale  
 4600 - 4615 Lime  
 4615 Rotary Total Depth

I hereby certify the foregoing statements to be true and correct to the best  
 of my knowledge.

GRAVES DRILLING CO., INC.

RECEIVED  
STATE CORPORATION COMMISSION

By

John C. Graves  
President


MAY 22 1979

STATE OF KANSAS )  
 ) SS.  
COUNTY OF SEDGWICK )CONSERVATION DIVISION  
Wichita, Kansas

Subscribed and sworn to before me, a Notary Public, this 22nd day of March, 1979.

Dorothy Gerber  
Notary Public

My commission expires January 18, 1982

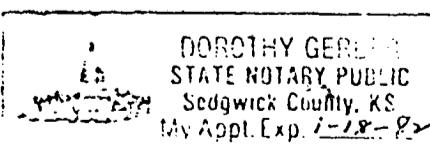

Copies to: Kansas Corporation Commission  
 Kansas Geological Society  
 Kansas Geological Survey