

STATE OF KANSAS  
STATE CORPORATION COMMISSION  
CONSERVATION DIVISION  
P. O. BOX 17027  
WICHITA, KANSAS 67217

WELL PLUGGING RECORD

Barber County, Sec. 18 Twp. 30 Rge. 13 (E) W (W)  
C NW NE

Location as "NE/CNW/SW" or footage from lines Earl M. Knighton

Lease Owner Earl M. Knighton

Lease Name Knackstedt Well No. 1

Office Address 710 Petroleum Bldg.; Wichita, Ks. 67202

Character of Well (completed as Oil, Gas or Dry Hole)

Date well completed August 1974

Application for plugging filed August 1974

Application for plugging approved August 1974

Plugging commenced September 9 1974


Plugging completed September 19 1974

Reason for abandonment of well or producing formation

If a producing well is abandoned, date of last production 19

Was permission obtained from the Conservation Division or its agents before plugging was commenced?

NORTH

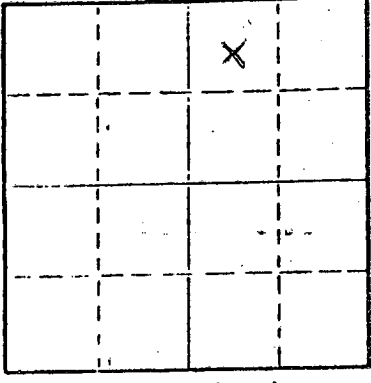

Locate well correctly on above Section Plat

Name of Conservation Agent who supervised plugging of this well

Producing formation Depth to top Bottom Total Depth of Well Feet

Show depth and thickness of all water, oil and gas formations.

OIL, GAS OR WATER RECORDS

CASING RECORD

FORMATION	CONTENT	FROM	TO	SIZE	PUT IN	PULLED OUT
				8 5/8"	216	None
				4 1/2"	4642	3514

RECEIVED  
STATE CORPORATION COMMISSION  
OCT 21 1974  
CONSERVATION DIVISION  
Wichita, Kansas

Describe in detail the manner in which the well was plugged, indicating where the mud fluid was placed and the method or methods used in introducing it into the hole. If cement or other plugs were used, state the character of same and depth placed, from feet to feet for each plug set.

September 9, 1974 Plugged off bottom. Dumped sand to 4300'. Mixed and dumped 4 sx of cement.

September 19, 1974 Plugged off top. Set 10' rock bridge at 360'. Filled casing and hole from 360' to base of cellar with 3000 lb. P.S.I. ready-mix concrete.


(If additional description is necessary, use BACK of this sheet)

Name of Plugging Contractor RUSSELL CASING PLUGGING, INC.  
Address P. O. Box 1082 ; Great Bend, Kansas 67530

STATE OF KANSAS COUNTY OF SEDGWICK ss.

EARL M. KNIGHTON (employee of owner) or (owner or operator) of the above-described well, being first duly sworn on oath, says: That I have knowledge of the facts, statements, and matters herein contained and the log of the above-described well as filed and that the same are true and correct. So help me God.

(Signature) Earl M. Knighton  
710 Petroleum Bldg., Wichita, Ks. 67202  
(Address)

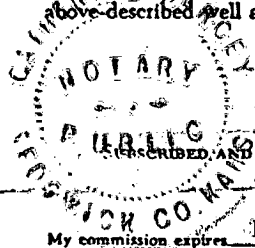

Subscribed and sworn to before me this 18th day of October, 1974

Catherine Darcey  
Catherine Darcey Notary Public.

15-007-20003-0068

MAGIC CIRCLE OIL CO. #1 T. KNACKSTEDT 18-30-13W  
 C NW NE  
 Contr. BON DRUG CO., INC. City BARBER  
 Geol. Pool MC  
 E. 1873 KB Co. 1/11/67 Cp. 3/30/67 IP 4PT OF 5500  
 MCFGPD, SIP 1427#  
 VIOLA 4514-24

LOG Tops	Depth	Datum
HEEB	3766	-1893
TOP	3784	-1911
DOUG SH	3802	-1934
DOUG SD	3846	-1973
BR IM	3948	-2075
LKC	3963	-2090
MARM	4370	-2497
CONG	4410	-2537
MISS	4444	-2571
VIOLA	4509	-2636
SIMP SH	4621	-2748
SIMP SD	4646	-2773
TD	4651	-2778

Csg. API 15-007-20,003  
 8" 4" 4642/130 SX;  
 DST 3835-55/1' 400' SW, BHP 1492-  
 45"/1425/1' FP 56-212#;  
 DST 4440-39/1' 30' DRL @ MD, BHP  
 90/45"-56/1' FP 34-34#;  
 DST 4517-52/1' 5700 MCFG/5" 6000  
 MCFG/6" STAB, BHP 1615-1593#;  
 FP 857-746#;  
 DST 4556-4603; WB 15" 30' MUD,  
 SSO, BHP 123/45"-67/1', FP 45-  
 45#;  
 CO PF 20/4514-24, MA 1000, REC LD,  
 4 PT TST 5500 MCFGPD; 1 PT TST  
 5550 MCFGPD/24 HRS, 1500 MCFGPD.  
 CORRECTED CARD: 4/6/67

INDEPENDENT OIL & GAS SERVICE WICHITA, KANSAS  
 WAS: 18-30-12W 1S: 18-30-13W

RECEIVED  
 STATE CORPORATION COMMISSION  
 AUG 21 1974  
 CONSERVATION DIVISION  
 Wichita, Kansas

RECEIVED  
 STATE CORPORATION COMMISSION  
 AUG 21 1974  
 CONSERVATION DIVISION  
 Wichita, Kansas