

STATE OF KANSAS
STATE CORPORATION COMMISSION

WELL PLUGGING RECORD

Give All Information Completely
Make Required Affidavit
Mail or Deliver Report to
Conservation Division
State Corporation Comm.
245 North Water
Wichita, KS 67202

Scott County. Sec. 8 Twp. 18 Rge. 31 E/W
Location as "NE/CNW $\frac{1}{4}$ SW $\frac{1}{4}$ " or footage from lines
C SW 1/4

Lease Owner Car-Ren Inc.

Lease Name McKean Well No. 1-8

Office Address 645 Garvey Bldg., Wichita, Kans.

Character of Well (Completed as Oil, Gas or Dry Hole)
Gas

Date Well completed 19

Application for plugging filed Jan. 10, 1977

Application for plugging approved Jan. 11, 1977

Plugging commenced Jan. 13, 1977

Plugging completed Jan. 15, 1977


Reason for abandonment of well or producing formation

Non Comercial value

If a producing well is abandoned, date of last production

None 19

Was permission obtained from the Conservation Division or
its agents before plugging was commenced? Yes

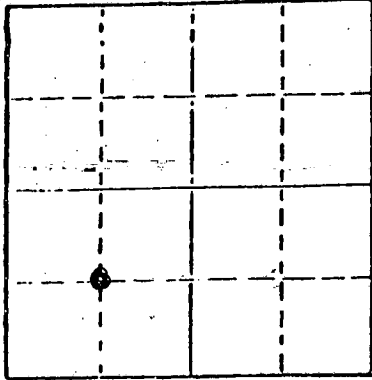

Locate well correctly on above
Section Plot

Name of Conservation Agent who supervised plugging of this well Mr. Balthazor
Producing formation Hugoton Depth to top 2772' Bottom 2779' Total Depth of Well 2815'
Show depth and thickness of all water, oil and gas formations.

OIL, GAS OR WATER RECORDS

CASING RECORD

FORMATION	CONTENT	FROM	TO	SIZE	PUT IN	PULLED OUT
Surface		0'	367'	8 5/8"	367'	0'
Hugoton		0'	2814'	4 1/2"	2814'	2368'

Describe in detail the manner in which the well was plugged, indicating where the mud fluid
was placed and the method or methods used in introducing it into the hold. If cement or other
plugs were used, state the character of same and depth placed, from _____ feet to
_____ feet for each plug set.

Pumped 1 sack hulls & 10 sacks cement to 2670'-Pressured to 750lbs.

Mud 2670' to 1000'

Pumped 25 sacks cement 1000' to 920'

Mud 920' to 350'

Pumped 25 sacks cement 350' to 270'

Mud 270' to 40'

Put bridge & 10 sacks cement 40' to 0'

Cut off 8 5/8" 42" below ground level.

RECEIVED
STATE CORPORATION COMMISSION

JAN 27 1977

CONSERVATION DIVISION
Wichita, Kansas

(If additional description is necessary, use BACK of this sheet)

Name of Plugging Contractor Midwest Casing Pulling
Box F, Sublette, Kans. 67877 Ks. Permit # 766

STATE OF Kansas COUNTY OF Haskell, ss.
I Edgar J. Eves (employee of owner) or (owner or operator)
of the above-described well, being first duly sworn on oath, says: That I have knowledge of
the facts, statements, and matters herein contained and the log of the above-described well
as filed and that the same are true and correct. So help me God.

(Signature) Edgar J. Eves
Box F, Sublette, Kansas 67877
(Address)

SUBSCRIBED AND SWORN TO before me this 21st day of January, 1977

Louisa L. Eves
Notary Public.

My commission expires Dec 6, 1980



DRILLERS LOG

COMPANY: Car-Ren, Inc.
 Suite 645 R.H.Garvey Building
 Wichita, Kansas 67202

LEASE: McKean No.1
 C SW/4 8-18-31W
 Scott County, Kansas

CONTRACTOR: Slawson Drilling Company, Inc.
 408 One Twenty Building
 Wichita, Kansas 67202

COMMENCED: 9/28/76

COMPLETED: 10/2/76

TOTAL DEPTH: 2815'

CASING: 369.89' used 8-5/8 set at 367' with 275 sx cement

0' to 323' 12 1/2" Surface Hole
 323' to 371' Surface Hole
 371' to 992' Shale & Shells
 992' to 2195' Shale
 2195' to 2449' Shale & Anhydrite
 2449' to 2815' Shale
 2815' RTD

STATE OF KANSAS
 COUNTY OF SEDGWICK

I, Rene Stucky, of the Slawson Drilling Company, Inc.
 upon oath state that the above and foregoing is a true and correct copy of the
 log of the McKean No.1 well.

Rene Stucky
 Rene Stucky, Engineering Ass't.

Subscribed and sworn to me on October 7, 1976.

Mary Lou Taylor
 Mary Lou Taylor, Notary

RECEIVED
 STATE CORPORATION COMMISSION

My commission expires January 17, 1977

JAN 10 1977

CONSERVATION DIVISION
 Wichita, Kansas

