

STATE OF KANSAS
STATE CORPORATION COMMISSION


Give All Information Completely
Make Required Affidavit
Mail or Deliver Report to:
Conservation Division
State Corporation Commission
212 No. Market
Wichita, Kansas

WELL PLUGGING RECORD

Wichita County, Sec. 5 Twp. 19s Rge. (E) 38 (W)

Location as "NE/CNWxSWx" or footage from lines. C SE 7/4
Lease Owner Shenandoah Oil Corp.
Lease Name Buller Well No. #1
Office Address 230 Hightower Bldg., Oklahoma City, Oklahoma
Character of Well (completed as Oil, Gas or Dry Hole) Dry Hole
Date well completed April 21, 19 75
Application for plugging filed April 23, 19 75
Application for plugging approved April 29, 19 75
Plugging commenced April 22, 19 75
Plugging completed April 22, 19 75
Reason for abandonment of well or producing formation Dry Hole

NORTH

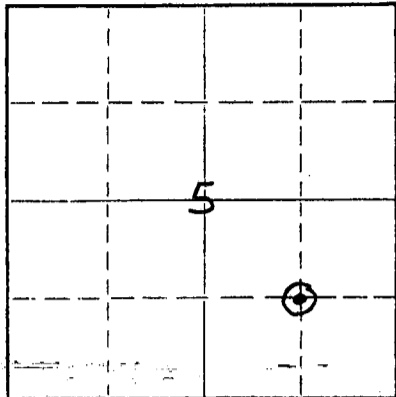

Locate well correctly on above Section Plat

If a producing well is abandoned, date of last production NONE 19
Was permission obtained from the Conservation Division or its agents before plugging was commenced? Yes

Name of Conservation Agent who supervised plugging of this well Gilbert Balthouzar
Producing formation NONE Depth to top ===== Bottom ----- Total Depth of Well 3225 Feet
Show depth and thickness of all water, oil and gas formations.

OIL, GAS OR WATER RECORDS

CASING RECORD

FORMATION	CONTENT	FROM	TO	SIZE	PUT IN	PULLED OUT
		Surface	367	8 5/8" OD	367'	0

Describe in detail the manner in which the well was plugged, indicating where the mud fluid was placed and the method or methods used in introducing it into the hole. If cement or other plugs were used, state the character of same and depth placed, from _____ feet to _____ feet for each plug set.

All cement plugs pumped thru drill pipe as follows:
Heavy mud from 2335 to 1350'
70 sx 50-50 pozmix cement fro 1350' to 1100'
Heavy mud from 1100 to 420'
20 sx 50-50 pozmix cement from 420 to 350
Heavy mud from 350 to 40'
10 sx 50-50 pozmix cement from 40' to 10'
Cut off 8 5/8" OD surface casing 3' below ground level
Weld on Steel Plate. Job Complete 11:00 a.m. 4-22-75

RECEIVED
STATE CORPORATION COMMISSION
JUL 23 1975
CONSERVATION DIVISION
Wichita, Kansas

(If additional description is necessary, use BACK of this sheet)


Name of Plugging Contractor Jim Snyder Drilling Company
Address Denver Club Building, Denver Colorado 80202

STATE OF _____, COUNTY OF _____, ss. _____ (employee of owner) or (owner or operator) of the above-described well, being first duly sworn on oath, says: That I have knowledge of the facts, statements, and matters herein contained and the log of the above-described well as filed and that the same are true and correct. So help me God.

(Signature) Donald F. Howard - Asst. Dir. Prod. Supt.
230 Hightower Bldg - Oklahoma City, Okla 73102
(Address)

SUBSCRIBED AND SWORN TO before me this 3rd day of June, 19 75
Mary M. Pulliam
Notary Public.

My commission expires January 3, 1979

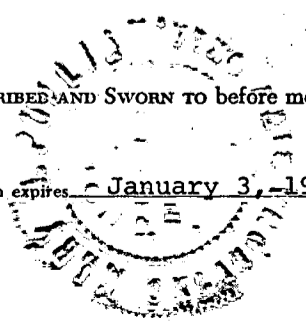

Shenandoah Oil Corporation
 #1 Buller
 C-SE $\frac{1}{4}$ Section 5, T19S, R38W
 Wichita County, Kansas

May 26, 1975

0'	-	65'	, Sand
65'	-	370'	, Sand and shale
370'	-	818'	, Shale and chalk
818'	-	1404'	, Shale, sand and chalk
1404'	-	1625'	, Shale and red beds
1625'	-	2145'	, Shale and salt
2145'	-	2425'	, Shale and shells
2425'	-	2635'	, Shale and sand
2635'	-	3225'	, Shale and lime

RECEIVED
 OKLA CITY,
 JUN 2 1975

I certify that the above sample description is a true and complete record of the formations encountered in the drilling of the captioned well as taken from the daily drilling reports of Jim Snyder Drilling Company.

JIM SNYDER DRILLING COMPANY

By: *Fran Rovlenchik*
 Fran Rovlenchik

RECEIVED
 STATE CORPORATION COMMISSION

JUL 18 1975

CONSERVATION DIVISION
 Wichita, Kansas