


WELL PLUGGING RECORD

Give All Information Completely
Make Required Affidavit
Mail or Deliver Report to:
Conservation Division
State Corporation Commission
211 No. Broadway
Wichita, Kansas

Wichita County, Sec. 36 Twp. 19S Rge. 35Wxx (W)

Location as "NE/CNW%SW%" or footage from lines C NE SW
Lease Owner D. R. Lauck Oil Company, Inc.
Lease Name Lehman Well No. 1
Office Address 301 S. Broadway, Wichita, Kansas
Character of Well (completed as Oil, Gas or Dry Hole) Dry Hole
Date well completed November 23, 19 65
Application for plugging filed November 23, 19 65
Application for plugging approved November 23, 19 65
Plugging commenced November 23, 19 65
Plugging completed November 23, 19 65
Reason for abandonment of well or producing formation Dry Hole

NORTH

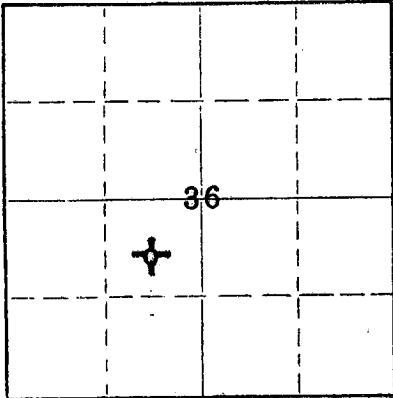

Locate well correctly on above
Section Plat

If a producing well is abandoned, date of last production _____ 19____
Was permission obtained from the Conservation Division or its agents before plugging was commenced? Yes

Name of Conservation Agent who supervised plugging of this well Bill Nichols
Producing formation _____ Depth to top _____ Bottom _____ Total Depth of Well 5035 Feet
Show depth and thickness of all water, oil and gas formations.

OIL, GAS OR WATER RECORDS

CASING RECORD

FORMATION	CONTENT	FROM	TO	SIZE	PUT IN	PULLED OUT
		0'	238'	8-5/8"	230'	None

Describe in detail the manner in which the well was plugged, indicating where the mud fluid was placed and the method or methods used in introducing it into the hole. If cement or other plugs were used, state the character of same and depth placed, from _____ feet to _____ feet for each plug set.

5035'-215' Mud
215'-211' Plug
211'-171' Cement, 35 sacks
171'- 35' Mud
35'- 31' Plug
31'- 6' Cement, 10 sacks (Bottom of cellar)

RECEIVED
STATE CORPORATION COMMISSION

DEC - 3 1965

CONSERVATION DIVISION
Wichita, Kansas

(If additional description is necessary, use BACK of this sheet)
Name of Plugging Contractor Lauck Drilling Company, Incorporated
Address 301 S. Broadway, Wichita, Kansas

STATE OF KANSAS, COUNTY OF SEDGWICK, ss.
John H. Knightley (employee of owner) or (owner or operator) of the above-described

well, being first duly sworn on oath, says: That I have knowledge of the facts, statements, and matters herein contained and the log of the above-described well as filed and that the same are true and correct. (So help me God.)


(Signature) John H. Knightley
301 S. Broadway, Wichita, Kansas
(Address)

SUBSCRIBED AND SWORN TO before me this 30th day of November, 19 65

Stella J. Lippa

Notary Public.

My commission expires March 12, 1967

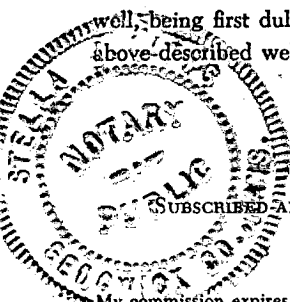

D. R. Lauck Oil Company, Inc.

Lehman #1

C NE SW Sec. 36-19S-35W
Wichita County, KansasCommenced: November 4, 1965
Completed: November 23, 1965Casing Record: 230' 8-5/8" Cemented with 180 sacks Cement,
4 sacks Calcium Chloride.

Elevation: GL 3078; DF 3080; KB 3082.

Drillers LogTops

Surface Clay & Sand	35		Samples
Sand	105		
Shale	855	Heebner	3937-855
Sand	915	Toronto	3947-865
Shale	1020	Lansing	3982-900
Sand	1050	Base Kansas City	4446-1364
Shale & Red Bed	1141	Fort Scott	4596-1514
Shale	1235	Cherokee	4609-1527
Sand	1375	Morrow	4802-1720
Red Bed & Shale	1480	Mississippian	
Anhydrite	1508	Ste. Genevieve	4942-1860
Shale & Shells	1575	St. Louis	5007-1925
Sand	1792	Rotary Total Depth	5035
Shale & Lime	1970		
Red Bed, Shale & Lime	2170	Core #1, 4794-97	
Shale & Lime	2895	Core #2, 4811-61	
Lime & Shale	3000	Core #3, 4861-94	
Shale & Lime	3220	Core #4, 4894-4933	
Lime	3375		
Lime & Shale	3656		
Lime	3765		
Shale & Lime	3958		
Lime	4038		
Lime & Chert	4079		
Lime, some cherty	4115		
Lime & Shale	4225		
Lime	4353		
Lime & Shale	4399		
Lime	4554		
Lime, some cherty	4605		
Lime	4655		
Lime & Shale	4710		
Lime & Shale Streaks	4755		
Lime	5035 RTD		

RECEIVED
STATE CORPORATION COMMISSION

D&A SEC - 3 1965

CONSERVATION DIVISION
Wichita, Kansas

Certified correct:


 John H. Knightley - Secretary