

CARD MUST BE TYPED

State of Kansas

CARD MUST BE SIGNED

8

NOTICE OF INTENTION TO DRILL

(see rules on reverse side)

Starting Date 6 1 87
month day year

API Number 15

101-21,390-0000

OPERATOR: License # 5123

Name Pickrell Drilling Company, Inc.

Address 110 N. Market, Suite 205

City/State/Zip Wichita, Kansas 67202

Contact Person Jay McNeil

Phone 262-8427

CONTRACTOR: License # 5123

Name Pickrell Drilling Company, Inc.

City/State Wichita, Kansas

Well Drilled For: Well Class: Type Equipment:

Oil SWD Infield Mud Rotary

Gas Inj Pool Ext. Air Rotary

OWWO Expl Wildcat Cable

If OWWO: old well info as follows:

Operator

Well Name

Comp Date Old Total Depth

I certify that well will comply with K.S.A. 55-101, et seq., plus eventually plugging hole to KCC specifications.

Date 5-22-87 Signature of Operator or Agent

For KCC Use:

Conductor Pipe Required feet; Minimum Surface Pipe Required

250 feet per Alt. 1 (2)

This Authorization Expires 11-22-87 Approved By 5-22-87

..... NW NE NE Sec. 2 Twp. 17 S. Rg. 28 _____
..... 4950 Ft. from South Line of Section
..... 990 Ft. from East Line of Section

East

West

(Note: Locate well on Section Plat on reverse side)

Nearest lease or unit boundary line 330 feet

County Lane

Lease Name Waterson Well # 1-A

Ground surface elevation feet MSL

Domestic well within 330 feet: yes no

Municipal well within one mile: yes no

Depth to bottom of fresh water 120'

Depth to bottom of usable water 900' / 2.50

Surface pipe by Alternate: 1 2

Surface pipe planned to be set 300+'

Conductor pipe required

Projected Total Depth 4650 feet

Formation Miss

Must be filed with the K.C.C. five (5) days prior to commencing well
This card void if drilling not started within six (6) months of date received by K.C.C.

RECEIVED

STATE CORPORATION COMMISSION


S-22-87

MAY 29 1987

A Regular Section of Land

1 Mile = 5,280 Ft.

CONSERVATION DIVISION
Wichita, Kansas

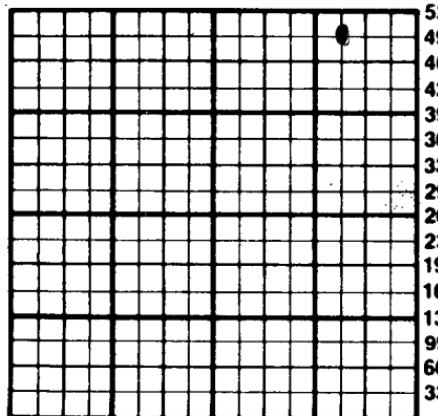

5280
4950
4620
4290
3960
3630
3300
2970
2640
2310
1980
1650
1320
990
660
330

Important procedures to follow:

1. Notify District office before setting surface casing.
2. Set surface casing by circulating cement to the top.
3. File completion forms ACO-1 with K.C.C. within 90 days of well completion, following instructions on ACO-1, side 1, and including copies of wireline logs.
4. Notify District office 48 hours prior to old well workover or re-entry.
5. Prior to filing Intent, prepare a proposed plugging plan in case well is D & A, then obtain approval of plan when calling district office prior to setting surface pipe.
6. Submit plugging report (CP-4) to K.C.C. after plugging is completed.
7. Obtain an approved injection docket number before disposing of salt water.
8. Notify K.C.C. within 10 days when injection commences or terminates.
9. If an alternate 2 completion, cement in the production pipe from below any usable water to surface within 120 days of spud date.

State Corporation Commission of Kansas

Conservation Division

200 Colorado Derby Building

Wichita, Kansas 67202

(316) 263-3238