

CARD MUST BE TYPED

State of Kansas

CARD MUST BE SIGNED

NOTICE OF INTENTION TO DRILL

(see rules on reverse side)

Starting Date May 18, 1987
month day year

API Number 15— 101-21,384-0000

OPERATOR: License # 4661
Name Galloway Petroleum Exploration, Inc.
Address 360 Broadway Plaza Bldg.
City/State/Zip Wichita, KS 67202
Contact Person Casey Galloway
Phone (316) 267-7355

SE. NW. NW Sec. 6 Twp. 17 S, Rg. 28 East
4290' Ft. from South Line of Section
4290' Ft. from East Line of Section

(Note: Locate well on Section Plat on reverse side)

CONTRACTOR: License # 5783
Name Galloway Drilling Co., Inc.
City/State Wichita, KS 67202

Nearest lease or unit boundary line 990' feet
County Lane
Lease Name Terwilliger Well # 1-6

Well Drilled For: Well Class: Type Equipment:
 Oil SWD Infield Mud Rotary
 Gas Inj Pool Ext. Air Rotary
 OWWO Expl Wildcat Cable

Ground surface elevation 2781 feet MSL
Domestic well within 330 feet: yes no
Municipal well within one mile: yes no
Depth to bottom of fresh water 500-180
Depth to bottom of usable water 1000-1380

If OWWO: old well info as follows:

Operator
Well Name
Comp Date Old Total Depth

Surface pipe by Alternate: 1 2
Surface pipe planned to be set 350'
Conductor pipe required
Projected Total Depth 4700 feet
Formation Mississippi

I certify that well will comply with K.S.A. 55-101, et seq., plus eventually plugging hole to KCC specifications.

Date 4/29/87 Signature of Operator or Agent Casey F. Galloway Title President

For KCC Use:

Conductor Pipe Required feet; Minimum Surface Pipe Required 200 feet per Alt. 40

This Authorization Expires 10-30-87 Approved By 4-30-87


Casey F. Galloway

Must be filed with the K.C.C. five (5) days prior to commencing well
This card void if drilling not started within six (6) months of date received by K.C.C.

Important procedures to follow:

1. Notify District office before setting surface casing.
2. Set surface casing by circulating cement to the top.
3. File completion forms ACO-1 with K.C.C. within 90 days of well completion, following instructions on ACO-1, side 1, and including copies of wireline logs.
4. Notify District office 48 hours prior to old well workover or re-entry.
5. Prior to filing Intent, prepare a proposed plugging plan in case well is D & A, then obtain approval of plan when calling district office prior to setting surface pipe.
6. Submit plugging report (CP-4) to K.C.C. after plugging is completed.
7. Obtain an approved injection docket number before disposing of salt water.
8. Notify K.C.C. within 10 days when injection commences or terminates.

**A Regular Section of Land
1 Mile = 5,280 Ft.**

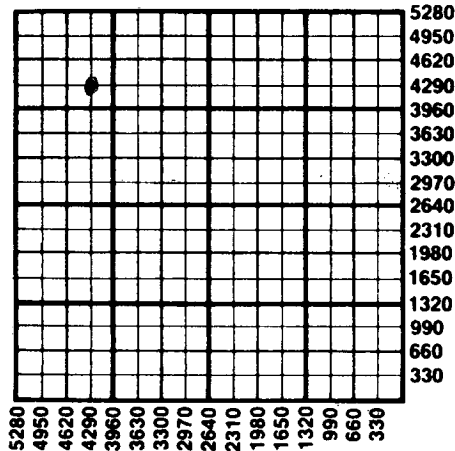

RECEIVED
STATE CORPORATION COMMISSION

APR 30 1987
4-30-87
CONSERVATION DIVISION
Wichita, Kansas

If an alternate 2 completion, cement in the production pipe from below any usable water to surface within 120 days of spud date.

State Corporation Commission of Kansas
Conservation Division
200 Colorado Derby Building
Wichita, Kansas 67202
(316) 263-3238