


Give All Information Completely
Make Required Affidavit
Mail or Deliver Report to:
Conservation Division
State Corporation Commission
800 Bittling Building
Wichita, Kansas

OR
FORMATION PLUGGING RECORD

Strike out upper line
when reporting plug-
ging off formations.

NORTH

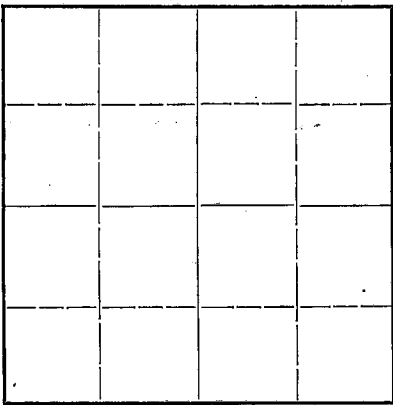

Locate well correctly on above
Section Plat

Saline County, Sec. 14 Twp. 16 Rge. 4 (E) (W)
Location as "NE 1/4 NW 1/4 SW 1/4" or footage from lines NW NW NW
Lease Owner: R. L. Carnahan
Lease Name: Frank J. J.
Office Address:
Character of Well (completed as Oil, Gas or Dry Hole) Dry Hole
Date well completed: 19
Application for plugging filed: 19
Application for plugging approved: 19
Plugging commenced: 11/31/43 1943
Plugging completed: 11/3/43 1943
Reason for abandonment of well or producing formation:

If a producing well is abandoned, date of last production: 19
Was permission obtained from the Conservation Division or its agents before plugging was com-
menced? _____

Name of Conservation Agent who supervised plugging of this well: ROEL DURKEE
Producing formation: _____ Depth to top: _____ Bottom: _____ Total Depth of Well: _____ Feet
Show depth and thickness of all water, oil and gas formations.

OIL, GAS OR WATER RECORDS

CASING RECORD

Formation	Content	From	To	Size	Put In	Pulled Out

Describe in detail the manner in which the well was plugged, indicating where the mud fluid was placed and the method or methods used in introducing it into the hole. If cement or other plugs were used, state the character of same and depth placed, from _____ feet to _____ feet for each plug set.

T. D. 3705 10 3/4 surface cas. set @ 300 ft.
Hole filled with heavy rotary mud to 200'
Set 1st plug @ 200' with 10 sacks of cement.
Hole filled with heavy rotary mud to 20 ft.
Set 2nd plug @ 20' with 5 sacks of cement.

PLUGGING
FILE SEC 14 16 2 4 W
BOOK PAGE 61 LINE 27

FEB 13 1943
02-16-1943

R. L. Carnahan

(If additional description is necessary, use BACK of this sheet)

Correspondence regarding this well should be addressed to 628 N. Crestway, R. L. Carnahan
Address: Wichita, Kansas

STATE OF Kansas, COUNTY OF Sedgwick, ss.
R. L. Carnahan, owner (employee of owner) or (owner or operator) of the above-described well,
being first duly sworn on oath, says: That I have knowledge of the facts, statements, and matters herein contained and the log of the above-
described well as filed and that the same are true and correct. So help me God.

(Signature) R. L. Carnahan
628 N. Crestway, Wichita, Kansas
(Address)

SUBSCRIBED AND SWORN to before me this 15th day of February, 1943
Virginia Lichty
Notary Public.
My commission expires March 3, 1945



15-169-00962-00-00

COMPANY: R. L. Carnahan
 CONTRACTOR: Hannum Drilling Company, Inc.
 (Tri-State Drilling Co. Inc.)
 FARM: Frank Sjo

LOCATION: NW NW NW
 Section 14-16-4W
 Saline County, Kansas

COMMENCED: December 19, 1942
 COMPLETED: January 16, 1943

CASING RECORD
 10" 300' Cem.
 7" 3696' Cem.

ELEVATION: 1357'
 PRODUCTION:

FORMATION	DEPTH	FORMATION	DEPTH
surface soil & clay	55	lime & shale	3305
red rock, shale & shells	85	shale	3469
shale & shells	307	cherty dolomite	3476
shale & anhydrite	320	cored - full rec.	3479
shale & shells	350	cherty dolomite	3515
broken lime	385	shale	3533
lime, sandy	460	lime	3560
lime & shale	940	lime & shale	3595
shale & shells	1070	lime	3613
shale & red rock	1080	sand	3617
sandy lime	1110	sandy dolomite	3645
lime & shale	1210	shale	3688
shale & lime	1485	dolomite	3705
shale	1540		
lime & shale	1595	TOTAL DEPTH	3705
shale & lime	1725		
lime	1755		
lime & shale	1800		
broken lime & shale	1895		
lime, broken	1985		
lime	2085		
lime & shale	2130		
lime, broken	2155		
shale & shells	2235		
shale & lime	2332		
lime	2365		
shale & lime	2380		
lime	2402		
sandy lime (soft)	2433		
lime	2525		
shale & lime	2600		
lime	2670		
shale & lime	2750		
shale & lime shells	2860		
shale & lime	2990		
Miss. lime	3020		
lime	3035		
chat & lime	3050		
lime & streaks of chat	3120		
cherty lime	3165		
cherty lime & shale	3200		
shale	3220		
lime	3260		

14 16 4W
 61 27

I hereby certify this to be a correct and accurate log of the above described well as shown by the drilling reports.



G. L. Hannum
 Subscribed and sworn to before me this 4th day of February, 1943

Clytell Smalley
 Notary Public

02-20-1943

My Commission expires: December 6, 1945