


STATE OF KANSAS
STATE CORPORATION COMMISSION

Give All Information Completely
Make Required Affidavit
Mail or Deliver Report to:
Conservation Division
State Corporation Commission
800 Bitting Building
Wichita, Kansas

OR
FORMATION PLUGGING RECORD

Strike out upper line
when reporting plug-
ging of formations.

Saline County. Sec. 3 Twp. 16S Rge. 4 (W)
Location as "NE $\frac{1}{4}$ NW $\frac{1}{4}$ SW $\frac{1}{4}$ " or footage from lines. NE $\frac{1}{4}$ NE $\frac{1}{4}$ SE $\frac{1}{4}$
Lease Owner. Charles W. Sheldon et al
Lease Name. Bengtson Well No. 1
Office Address. 109 $\frac{1}{2}$ N. Santa Fe, Salina, Kansas
Character of Well (completed as Oil, Gas or Dry Hole). Dryhole
Date well completed. August 11, 1951 19
Application for plugging filed. August 14, 1951 19
Application for plugging approved. August 14, 1951 19
Plugging commenced. August 14, 1951 19
Plugging completed. August 16, 1951 19
Reason for abandonment of well or producing formation.

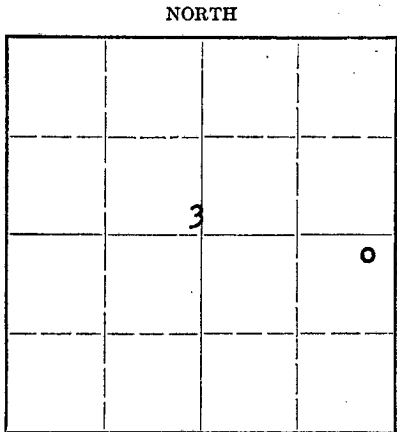

Locate well correctly on above
Section Plat

If a producing well is abandoned, date of last production 19
Was permission obtained from the Conservation Division or its agents before plugging was com-
menced? Yes

Name of Conservation Agent who supervised plugging of this well. Mr. Ruel Durkee
Producing formation. none Depth to top. Bottom. Total Depth of Well. 3447 Feet
Show depth and thickness of all water, oil and gas formations.

OIL, GAS OR WATER RECORDS

CASING RECORD

Formation	Content	From	To	Size	Put In	Pulled Out
				8 5/8	412	none

Describe in detail the manner in which the well was plugged, indicating where the mud fluid was placed and the method or methods used in introducing it into the hold. If cement or other plugs were used, state the character of same and depth placed, from... feet to ... feet for each plug/set.

Rent in hole with one-half of the drillpipe; jetted the pits and circulated heavy mud on-half hour; came out of hole laying down drillpipe and filled hole with mud and placed a 5 sack cement plug in top of surface pipe

RECEIVED
AUG 18 1951
CONSERVATION DIVISION
Wichita, Kansas

(If additional description is necessary, use BACK of this sheet)
Correspondence regarding this well should be addressed to L. B. JACKSON DRILLING COMPANY
Address. 503 McBirney Bldg.,
Tulsa, Oklahoma.

STATE OF Oklahoma COUNTY OF Tulsa, ss.
M. F. Ashwill (employee of owner) or ~~owner~~ of the above-described well,
being first duly sworn on oath, says: That I have knowledge of the facts, statements, and matters herein contained and the log of the above-described well as filed and that the same are true and correct. So help me God.

(Signature) M. F. Ashwill Auditor

L. B. Jackson Drilling Company
503 McBirney Bldg., Tulsa, Oklahoma.
August 17th day of August 1951

Subscribed and sworn to before me this 17th day of August 1951
My commission expires March 18, 1954
Joe Christian Notary Public.



PLUGGING
FILE SEC 3 T 16 R 4W
BOOK PAGE 102 NE 2-3

15-169-00099-00-00

WELL RECORD

Charles W. Sheldon et al
109 1/2 N. Santa Fe, Salina, Kansas

Bengtson #1
NE 1/4 NE 1/4 SE 1/4 Sec. 3-16S-4T
Saline County, Kansas

Total Depth 3747 ft.

Elevation 1326 DF
1323 Gr.

Drilling Commenced 7-28-51
Drilling Completed 8-11-51

Casing Record:
8 5/8" set at 412' with 300 sacks cement

Formation	Top	Bottom	Formation	Top	Bottom
Surface	0	40	Shale, lime	2585	2670
Shells	40	123	Lime	2670	2680
Shale & shells	123	410	Lime, shale	2680	2755
Shale & lime	410	500	Shale	2755	2848
Lime, shale, sand	500	755	Shale, lime	2848	2933
Lime & shale	755	900	Lime	2933	3069
Shale, lime w/chert	900	1080	Soft ?	3069	3088
Sandy lime, shale & shells	1080	1300	Lime & chert	3088	3107
Shale & lime	1300	1492	Lime	3107	3159
Shale & shells	1492	1692	Lime & shale	3159	3184
Shale, lime, chert	1692	1845	Shale	3184	3357
Lime	1845	1915	Shale & lime	3357	3444
Shale	1915	1931	Dolomite	3444	3447
Shale & lime	1931	2260	Total Depth		3447
Shale	2260	2315			
Lime	2315	2360			
Lime & shale	2360	2527			
Shale sandy	2527	2559			
Lime	2559	2585			

The above Well Log is complete and correct to the best of my knowledge.

Contractor: L. B. Jackson Drilling Company, 503 McBirney Bldg., Tulsa, Oklahoma.

PLUGGING
 FILE SEC 3 T 16 R 4W
 BOOK PAGE 107 LINE 23
 STATE OF OKLAHOMA
 COUNTY OF TULSA

NOTARY PUBLIC
 AUG 18 1951
 CONSERVATION DIVISION
 Wichita, Kansas
 SS 08-18-1951

L. B. JACKSON DRILLING COMPANY
 By: M. F. Ashwill
 M. F. Ashwill, Auditor

On this 17th day of August, 1951, before me, a Notary Public, in and for said County and State, personally appeared M. F. Ashwill, to me personally known to be the identical person who executed the foregoing instrument, and acknowledged to me that he executed the same as his free and voluntary act and deed, for the uses and purposes therein set forth.

My commission expires: March 18, 1954

Joe Christian
 Notary Public