


15-169-20228-00-00

STATE OF KANSAS
STATE CORPORATION COMMISSION

WELL PLUGGING RECORD

Give All Information Completely
Make Required Affidavit
Mail or Deliver Report to
Conservation Division
State Corporation Comm.
245 North Water
Wichita, KS 67202

Saline County, Sec. 22 Twp. 16 Rge. 3W XXX
Location as "NE/CNW/SW" or footage from lines
1650' FSL 1650' FWL SW/4
Lease Owner Range Oil Company, Inc.
Lease Name Wells "A" Well No. 1
Office Address 240 Page Court, 220 W. Douglas, Wichita, Kansas
Character of Well (Completed as Oil, Gas or Dry Hole)
Dry Hole

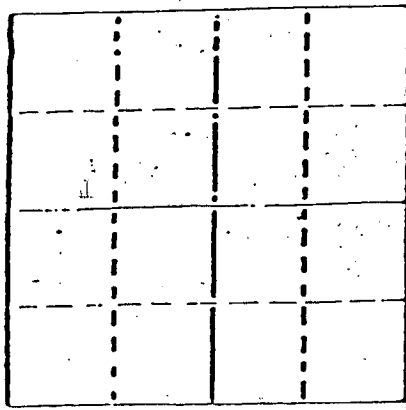

Date Well completed 10-1 1983
Application for plugging filed 10-1 1983
Application for plugging approved 10-1 1983
Plugging commenced 10-1 1983
Plugging completed 10-1 1983
Reason for abandonment of well or producing formation
Dry Hole

If a producing well is abandoned, date of last production 19

Was permission obtained from the Conservation Division or its agents before plugging was commenced? Yes

Name of Conservation Agent who supervised plugging of this well KCC-Notified Merlin Unruh
Producing formation Depth to top Bottom Total Depth of Well 563
Show depth and thickness of all water, oil and gas formations.

OIL, GAS OR WATER RECORDS

CASING RECORD

FORMATION	CONTENT	FROM	TO	SIZE	PUT IN	PULLED OUT
				8-5/8	259	0

Describe in detail the manner in which the well was plugged, indicating where the mud fluid was placed and the method or methods used in introducing it into the hold. If cement or other plugs were used, state the character of same and depth placed, from _____ feet to _____ feet for each plug set.

Hole plugged with 4-1/2 yards of Redimix + 2% CAC1 from 320' to surface.

Mr. Unruh retained copies of the cementing ticket.

(If additional description is necessary, use BACK of this sheet)


Name of Plugging Contractor Range Drilling Company, Inc.

STATE OF Kansas COUNTY OF Sedgwick, ss.
Gary L. Reed (employee of owner) or (owner or operator)

the above-described well, being first duly sworn on oath, says: That I have knowledge of the facts, statements, and matters herein contained and the log of the above-described well filed and that the same are true and correct. So help me God.

(Signature) Gary L. Reed
240 Page Court, 220 W. Douglas, Wichita, Kansas
(Address)

SUBSCRIBED AND SWORN TO before me this 19th day of October, 1983

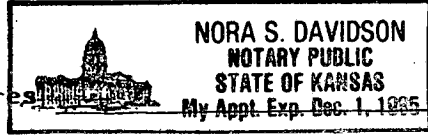

commission expires

Nora S. Davidson
Notary Public.

