


Give All Information Completely
Make Required Affidavit
Mail or Deliver Report to:
Conservation Division
State Corporation Commission
800 Biting Building
Wichita, Kansas

WELL PLUGGING RECORD

NORTH

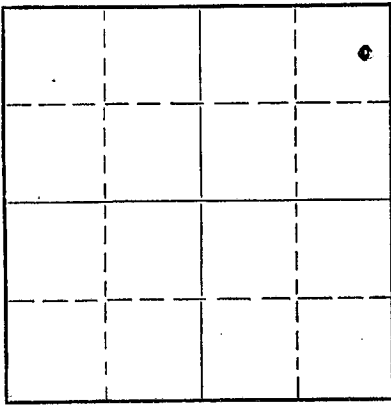

Locate well correctly on above
Section Plat

Saline County. Sec. 19 Twp. 16S Rge. 3 (E) W (W)
Location as "NE/CNW/SW" or footage from lines C E/2 NE NE
Lease Owner The Atlantic Refining Company
Lease Name Bethany College Well No. 1
Office Address P. O. Box 17, Great Bend, Kansas
Character of Well (completed as Oil, Gas or Dry Hole) Oil
Date well completed 12-18 19 54
Application for plugging filed 4-9 19 56
Application for plugging approved 4-10 19 56
Plugging commenced 4-24 19 56
Plugging completed 5-1 19 56
Reason for abandonment of well or producing formation Well depleted.

If a producing well is abandoned, date of last production 5-4 19 55
Was permission obtained from the Conservation Division or its agents before plugging was commenced? Yes.

Name of Conservation Agent who supervised plugging of this well Mr. Ruel Durkee, Box 597, McPherson, Kansas
Producing formation Maquoketa Dolomite Depth to top 3463' Bottom 3470' Total Depth of Well 3470' Feet
Show depth and thickness of all water, oil and gas formations.

OIL, GAS OR WATER RECORDS

CASING RECORD

FORMATION	CONTENT	FROM	TO	SIZE	PUT IN	PULLED OUT
				10-3/4"	171'	0
				4-1/2	3468'	2776'

Describe in detail the manner in which the well was plugged, indicating where the mud fluid was placed and the method or methods used in introducing it into the hole. If cement or other plugs were used, state the character of same and depth placed, from _____ feet to _____ feet for each plug set.

TD 3470'. Put 4 cu. ft. sand from 3469' to 3455'. Dumped 4 sacks cement from 3455' to 3415' and filled hole with water and shot casing at 2775'. Pulled 61 joints casing. Mudded hole. Pulled the rest of casing which was 22 joints. Filled hole with mud up to 170'. At 170' to 160', set 10' rock bridge. Dumped 20 sacks cement, let set over night and checked top of cement at 115'. Bailed surface casing dry and filled it with heavy mud to within 12' of surface. Put a bridge at 12' from surface and dumped 5 sacks of cement.

(If additional description is necessary, use BACK of this sheet)

Name of Plugging Contractor Wilson, Inc.
Address Great Bend, Kansas

STATE OF Kansas, COUNTY OF Barton, ss.

Stanton K. Myers (employee of owner) or (owner or operator) of the above-described well, being first duly sworn on oath, says: That I have knowledge of the facts, statements, and matters herein contained and the log of the above-described well as filed and that the same are true and correct. So help me God.

(Signature) Stanton K. Myers
P. O. Box 17, Great Bend, Kansas
(Address)

SUBSCRIBED AND SWORN TO before me this 2nd day of May, 19 56

Ellene C. Buddy
Notary Public.


My Commission expires 12/10/58

24-7368-S 3-53-20M

RECEIVED
STATE CORPORATION COMMISSION

MAY 31 1956
05-23-1956
CONSERVATION DIVISION
Wichita, Kansas

PLUGGING
FILE SEC 19 T 16 R 3W
BOOK PAGE 52 LINE 25

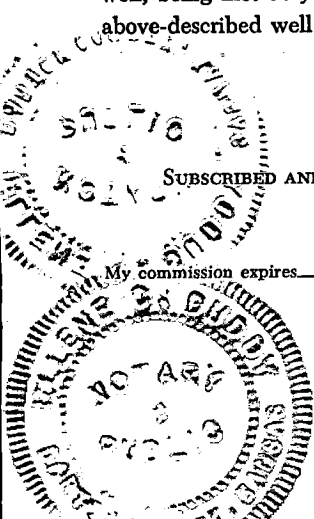

15-1109-00938-00-00

THE ATLANTIC REFINING COMPANY
830 Kennedy Building
Tulsa, Oklahoma

WELL LOG

Bethany College No. 1

Location: C E/2 NE NE of Section 19-16S-3W, Saline County, Kansas.

Lease Number: KS-12,217

Elevations: HKB 1384.08', DF 1381', GL 1378.70'.

Spudded: 12 Midnight, November 26, 1954. Reached Total Depth: December 7, 1954.

Contractor: Kiefer & Krause Drilling Company, Inc.

Casing Record: Ran 4 joints (160.56') of 10-3/4" O.D. 21.6# Armaco Spiral Weld Slip Joint casing and set at 169.29'. Cemented with 140 sacks of Pozmix cement plus 1% calcium chloride.

Ran 105 joints (3458.79') of 4-1/2" O.D. 8 Rd. 9.5# H-40 ST&C National casing and set at 3465'. Cemented with 200 sacks of Pozmix #1 cement.

FORMATION RECORD

Top soil and clay	0'- 30'
Shale and shells	30'- 70'
Sandy shale	70'- 171'
Shale & shells	171'- 441'
Anhydrite	441'- 480'
Lime and shale	480'- 1145'
Shale and shells	1145'- 1405'
Lime, shale and shells	1405'- 1630'
Shale and lime	1630'- 3170'
Lime	3170'- 3205'
Lime and shale	3205'- 3390'
Lime	3390'- 3469'

Total Depth 3469'.

RECEIVED
STATE CORPORATION COMMISSION

MAY 31 1956

CONSERVATION DIVISION
Wichita, Kansas

05-03-1956

cc-
Kansas Well Log Bureau
508 East Murdock
Wichita, Kansas

Mr. S. K. Myers
Great Bend

Mr. H. H. Trager
Wichita, Kansas

PLUGGING
FILE SEC 19 T 16 R 3W
BOOK PAGE 52 LINE 25

APR 1 1956
CONFIDENTIAL