


Give All Information Completely
Make Required Affidavit
Mail or Deliver Report to:
Conservation Division
State Corporation Commission
211 No. Broadway
Wichita, Kansas

WELL PLUGGING RECORD

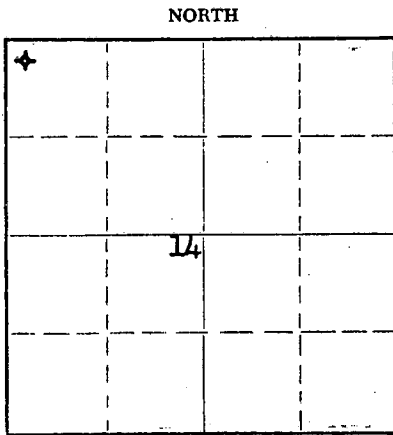

Locate well correctly on above Section Plat

Saline County, Sec. 14 Twpl 6S Rge. (E) 3 (W)
Location as "NE/CNWxSWx" or footage from lines NW/4, NW/4, NW/4
Lease Owner Dean Allison & A. D. Allison
Lease Name Bloomberg Well No. 1
Office Address 3212 East Kellogg, Wichita, Kansas
Character of Well (completed as Oil, Gas or Dry Hole) Dry Hole
Date well completed October 15, 19 59
Application for plugging filed October 15, 19 59
Application for plugging approved 19
Plugging commenced October 15, 19 59
Plugging completed October 15, 19 59
Reason for abandonment of well or producing formation Dry Hole

If a producing well is abandoned, date of last production 19
Was permission obtained from the Conservation Division or its agents before plugging was commenced? Yes (verbal)

Name of Conservation Agent who supervised plugging of this well Cecil Jones
Producing formation _____ Depth to top _____ Bottom _____ Total Depth of Well 3401 Feet
Show depth and thickness of all water, oil and gas formations.

OIL, GAS OR WATER RECORDS

CASING RECORD

FORMATION	CONTENT	FROM	TO	SIZE	PUT IN	PULLED OUT
				8-5/8"	306'	None

Describe in detail the manner in which the well was plugged, indicating where the mud fluid was placed and the method or methods used in introducing it into the hole. If cement or other plugs were used, state the character of same and depth placed, from _____ feet to _____ feet for each plug set.

3401' to 180' - Heavy mud
180' - Set wood plug
180' to 135' - 15 sacks of cement
135' to 30' - Heavy mud
30' - Set wood plug
30' to 6' - 8 sacks of cement
6' to 0' - Surface soil

RECEIVED
STATE CORPORATION COMMISSION

OCT 28 1959

CONSERVATION DIVISION
Wichita, Kansas

1028-1959

(If additional description is necessary, use BACK of this sheet)

Name of Plugging Contractor Melland Drilling Company, Inc.
Address 1111 North Main Street, Hutchinson, Kansas


STATE OF Kansas COUNTY OF Sedgewick, ss.
Dean Allison (employee of owner) or (owner or operator) of the above-described well, being first duly sworn on oath, says: That I have knowledge of the facts, statements, and matters herein contained and the log of the above-described well as filed and that the same are true and correct. So help me God.

(Signature) Dean Allison
7902 E Indianapolis (Address)

Subscribed and Sworn to before me this 27th day of October, 1959

Scott Shuckey
Notary Public.

10-15-1963

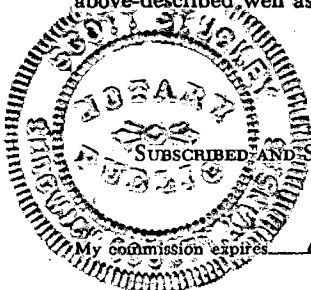

15-169-00754-00-00

to State Corp

W E L L R E C O R D

LEASE: Bloomberg

WELL NO. 1

LOCATION NW/4 NW/4 NW/4
Section 14-16S-3W
Saline County, Kansas

DRILLING COMMENCED: 10/7/59

DRILLING COMPLETED: 10/15/59
(rotary)

OPERATOR: Dean Allison & A. D. Allison
3212 East Kellog
Wichita, Kansas

CONTRACTOR: Melland Drilling Company, Inc.
1111 North Main Street
Hutchinson, Kansas

CASING RECORD: 8-5/8" OD casing set at 306' and cemented with 215 sacks of cement. Cement circulated.

<u>FORMATION</u>	<u>FROM</u>	<u>TO</u>
Surface soil & clay	0	45
Sand	45	120
Shale, shells & gypsum	120	260
Lime & gypsum	260	330
Anhydrite	330	420
Red Bed, shale & lime	420	520
Lime & shale	520	1020
Shale w/ shells	1020	1750
Lime & shale	1750	2440
Lime	2440	2490
Lime & shale	2490	2855
Mississippi Lime	2855	3145
Shale	3145	3395
Lime	3395	3401

ROTARY TOTAL DEPTH

3401

Plugged back from 3401' to 180' with heavy mud. Set wood plug at 180'. Plugged back from 180' to 135' with 15 sacks of cement. Plugged back from 135' to 30' with heavy mud. Set wood plug at 30'. Plugged back from 30' to 6' with 8 sacks of cement. Plugged back from 6' to 0' with surface soil. Plugged and abandoned October 15, 1959.

RECEIVED
STATE CORPORATION COMMISSION
OCT 28 1959
CONSERVATION DIVISION
Wichita, Kansas
10-28-1959