


WELL PLUGGING RECORD

Give All Information Completely
Make Required Affidavit
Mail or Deliver Report to:
Conservation Division
State Corporation Commission
211 No. Broadway
Wichita, Kansas

NORTH

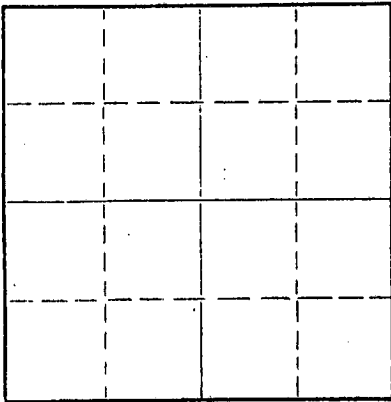

Locate well correctly on above
Section Plat

Saline County. Sec. 7 Twp. 16 Rge. 3 (E) (W)
Location as "NE/CNW/SW" or footage from lines C-SE/4 NE/4
Lease Owner V. P. DeWeese, Sr.
Lease Name Anderson Well No. 1
Office Address 900 N. W. 3rd. St., ABILENE, Kansas 67410
Character of Well (completed as Oil, Gas or Dry Hole) Dry
Date well completed May 14, 19 67
Application for plugging filed 19
Application for plugging approved 19
Plugging commenced 19
Plugging completed May 14, 19 67
Reason for abandonment of well or producing formation Dry

If a producing well is abandoned, date of last production 19
Was permission obtained from the Conservation Division or its agents before plugging was commenced? Yes

Name of Conservation Agent who supervised plugging of this well Gilbert Toman, Holyrood, Kansas
Producing formation Depth to top Bottom Total Depth of Well Feet
Show depth and thickness of all water, oil and gas formations.

OIL, GAS OR WATER RECORDS

CASING RECORD

FORMATION	CONTENT	FROM	TO	SIZE	PUT IN	PULLED OUT
Shale		0	280'	8 5/8"	280'	None
Lime & Shale		280'	350'	8 5/8"	70'	None

Describe in detail the manner in which the well was plugged, indicating where the mud fluid was placed and the method or methods used in introducing it into the hole. If cement or other plugs were used, state the character of same and depth placed, from feet to feet for each plug set.

Set first plug at 325 ft. and put in 25 sacks cement.
Filled with mud to 40 ft. and set 2nd. plug, put in 10
sacks cement and 2 sacks in rathole. Job completed at
7:00 P.M., May 12, 1967 by State Plugger, Gilbert Toman,
Holyrood, Kansas.....


RECEIVED
STATE CORPORATION COMMISSION
MAY 17 1967
05-17-1967
CONSERVATION DIVISION
Wichita, Kansas

(If additional description is necessary, use BACK of this sheet)
Name of Plugging Contractor Blackstone Drilling, Inc.
Address Box # 455, McPherson, Kansas 67460

STATE OF KANSAS, COUNTY OF DICKINSON, ss.
V. P. DeWeese, Sr. (operator) of the above-described
well, being first duly sworn on oath, says: That I have knowledge of the facts, statements, and matters herein contained and the log of the
above-described well as filed and that the same are true and correct. So help me God.
(Signature) V. P. DeWeese Sr.
900 N. W. 3rd. St., Abilene, Kansas 67410
(Address)

SUBSCRIBED AND SWORN TO before me this 16 day of May, 19 67

My commission expires May 10, 1970
Notary Public.

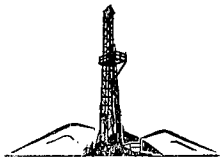

Blackstone Drilling, Inc.

Box 455 • 523 West Kansas • Phone CH 1-1250

McPHERSON • KANSAS

67460

May 15, 1967

15-169-20004-00-00

COMPANY: V. P. DE WEESE, SR.
CONTRACTOR: BLACKSTONE DRILLING, INC.
FARM: ANDERSON # 1
LOCATION: C-SE/4-NE/4, Sec. 7-16-3,
Saline County, Kansas
COMMENCED: May 5, 1967
COMPLETED: May 12, 1967
ELEVATION: Estimated 1365 K.B.

0	to	280	Shale
280	to	1040	Lime & Shale
1040	to	1800	Shale & Lime
1800	to	1940	Lime
1940	to	2325	Lime & Shale
2325	to	2660	Lime
2660	to	2940	Lime & Shale
2940	to	3187	Mississippi
3187	to	3245	Lime
3245	to	3465	Shale & Lime
		3465	T. D.

RECEIVED
STATE COMMISSION
MAY 17 1967
05-17-1967
CONSERVATION DIVISION
Wichita, Kansas

Cut 12 1/4 in. hole to 350 ft. and run 352 ft. of 8 5/8 in. surface pipe and cemented with 160 sacks on bottom to 350 ft. Plug down at 12:00 A.M., May 5, 1967. Cut 7 7/8 in. hole to 3465 ft. Hole dry and abandoned. Set 1st. plug at 325 ft. and put in 25 sacks cement. Filled with mud to 40 ft. and set 2nd. plug, put in 10 sacks cement and 2 sacks in rathole. Job completed at 7:00 P.M., May 12, 1967 by State Plugger, Gilbert Toman, Holyrood, Kansas.

TOPS: ANhydrite - 275' Mississippi - 2920' Kidnerhook - 3220'
Maquoketa Shale - 3420' Maquoketa Bolemite - 3452'

Measurements taken from K. B.

CERTIFICATE

I, H. J. Plouffe, President of Blackstone Drilling, Inc. do hereby certify that the above and foregoing is a true and correct copy of log on your Anderson #1, located on the C-SE, NE/4 of Sec. 7-16-3, Saline County, Kansas as reflected by the files of the BLACKSTONE DRILLING, INC.

H. J. Plouffe, President

Subscribed and sworn to before me a Notary Public in and for McPherson County, Kansas this 15th day of May, 1967.

Ruth McVay - Notary Public

My Commission Expires: December 18, 1969.

