

FORM MUST BE TYPED  
FORM C-1 4/90

**EFFECTIVE DATE:** 10-28-91  
**NOTICE OF INTENTION TO DRILL**

State of Kansas

FORM MUST BE SIGNED  
ALL BLANKS MUST BE FILLED

Must be approved by the K.C.C. five (5) days prior to commencing well

*Drill 1*  
Expected Spud Date: Nov. 5 1991  
month day year

C SW NE Sec 18 Twp 20 S, Rg 33 X West

3300 feet from South line of Section  
1980 feet from East line of Section  
(Note: Locate well on Section Plat on Reverse Side)

OPERATOR: License # 4058  
Name: American Warrior, Inc.  
Address: P. O. Box 399  
City/State/Zip: Garden City, KS 67846  
Contact Person: Michael J. Wreath  
Phone: (316) 275-2963

County: Scott  
Lease Name: Mark Well #: 1  
Field Name: Roth Felder

CONTRACTOR: License #: 5421  
Name: Sage Drilling Co., Inc.

Is this a Prorated Field? X yes no

Target Formation(s): Morrow

Well Drilled For: Well Class: Type Equipment:  
X Oil ... Inj X Infield X Mud Rotary  
... Gas ... Storage ... Pool Ext. ... Air Rotary  
... OWWO ... Disposal ... Wildcat ... Cable  
... Seismic; ... # of Holes

Nearest lease or unit boundary: 660 feet  
Ground Surface Elevation: est. 2980 feet MSL  
Domestic well within 330 feet: ... yes X no  
Municipal well within one mile: ... yes X no  
Depth to bottom of fresh water: 140  
Depth to bottom of usable water: 1200  
Surface Pipe by Alternate: ... 1 X 2  
Length of Surface Pipe Planned to be set: 350'

If OWWO: old well information as follows:  
Operator: \_\_\_\_\_  
Well Name: \_\_\_\_\_  
Comp. Date: \_\_\_\_\_ Old Total Depth \_\_\_\_\_

Length of Conductor pipe required: \_\_\_\_\_  
Projected Total Depth: 4850  
Formation at Total Depth: Mississippian  
Water Source for Drilling Operations:  
... well ... farm pond X other

Directional, Deviated or Horizontal wellbore? ... yes X no  
If yes, total depth location: \_\_\_\_\_

DWR Permit #: Not required  
Will Cores Be Taken? ... yes X no  
If yes, proposed zone: \_\_\_\_\_

**AFFIDAVIT**

The undersigned hereby affirms that the drilling, completion and eventual plugging of this well will comply with K.S.A. 55-101, et. seq.

It is agreed that the following minimum requirements will be met:

1. The appropriate district office shall be notified before setting surface pipe;
2. The minimum amount of surface pipe as specified above shall be set by circulating cement to the top; in all cases surface pipe shall be set through all unconsolidated materials plus a minimum of 20 feet into the underlying formation;
3. If the well is dry, a plugging proposal shall be submitted to the district office. An agreement between the operator and the district office on plug length and placement is necessary prior to plugging;
4. The appropriate district office will be notified before well is either plugged or production casing is cemented in;
5. If an Alternate II completion, production pipe shall be cemented from below any usable water to surface within 120 days of spud date. In all cases, notify district office prior to any cementing.

I hereby certify that the statements made herein are true and to the best of my knowledge and belief.

Date: Sept. 27, 1991 Signature of Operator or Agent: *Michael J. Wreath* Title: *Geo/Eng'ist*

**FOR KCC USE:**

API # 15- 171-20, 440-00-00  
Conductor pipe required None feet  
Minimum surface pipe required 200 feet per Alt. A ②  
Approved by: [Signature] DATE: 10-23-91  
EFFECTIVE DATE: 10-28-91  
This authorization expires: 4-23-92  
(This authorization void if drilling not started within 6 months of effective date.)  
Spud date: \_\_\_\_\_ Agent: \_\_\_\_\_

40 A  
150' C

CONSERVATION DIVISION  
WICHITA, KS

OCT 15 1991

RECEIVED  
KANSAS CORPORATION COMMISSION

18  
20  
330

**REMEMBER TO:**

- File Drill Pit Application (form CDP-1) with Intent to Drill;
- File Completion Form ACO-1 within 120 days of spud date;
- File acreage attribution plat according to field proration orders;
- Notify appropriate district office 48 hours prior to workover or re-entry;
- Submit plugging report (CP-4) after plugging is completed;
- Obtain written approval before disposing or injecting salt water.


EFFICIENT DATE

PLAT OF ACREAGE ATTRIBUTABLE TO A WELL

State Corporation Commission, Conservation Division  
200 Colorado Derby Bldg. Wichita, Kansas 67202

OPERATOR American Warrior, Inc. LOCATION OF WELL:  
 LEASE Mark 3300 feet north of SE corner  
 WELL NUMBER 1 1980 feet west of SE corner  
 FIELD Roth Felder CSWNE Sec. 18 T 20 R 33 E/W  
 COUNTY Scott  
 NO. OF ACRES ATTRIBUTABLE TO WELL 40 IS SECTION X REGULAR IRREGULAR?  
 IF IRREGULAR, LOCATE WELL FROM NEAREST  
 DESCRIPTION OF ACREAGE SE NE Sec. 18 CORNER BOUNDARY.

NOTE: If plat depicted is insufficient for your circumstances, you may attach your own scaled or surveyed plat.

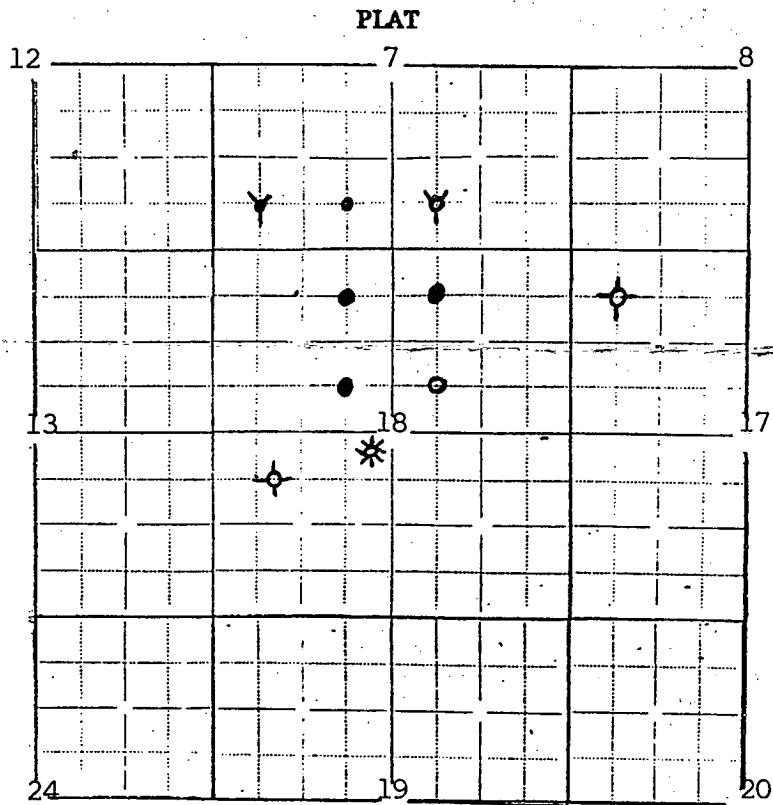

In plotting the proposed location of the well, you must show:

- 1) The manner in which you are using the depicted plat by identifying section lines, i.e. 1 section, 1 section with 8 surrounding partial sections, 4 sections, 16 sections, etc.;
- 2) the well's location relative to the location of other wells producing from the same common source of supply in adjoining drilling units, pursuant to K.A.R. 82-3-108, 82-3-207, 82-3-312, or special orders of the Commission;
- 3) the distance of the proposed drilling location from the section's east and south lines; and
- 4) the distance to the nearest lease or unit boundary line.

I hereby certify that the statements made herein are true and to the best of my knowledge and belief.

Signature of Operator or Agent Michael J. Wreath  
 Date Sept 26, 1991 Title Geologist