

CARD MUST BE TYPED

State of Kansas

CARD MUST BE SIGNED

# NOTICE OF INTENTION TO DRILL

(see rules on reverse side)

Expected Spud Date. August 14 1987  
month day year

API Number 15— 171-20, 362-00-00 ✓  
E/2 NW/4 SW/4 Sec. 18 Twp. 20 S, Rg. 33 X East  
1980 Ft. from South Line of Section  
4290 Ft. from East Line of Section

OPERATOR: License # 5316  
Name Falcon Exploration Inc.  
Address 1531 KSB&T Bldg.  
City/State/Zip Wichita, Kansas 67202  
Contact Person. Kerry D. Parham  
Phone (316) 262-1378

(Note: Locate well on Section Plat on reverse side)

Nearest lease or unit boundary line 990 feet  
County Scott

CONTRACTOR: License # 5302  
Name Red Tiger Drilling Company  
City/State Wichita, Kansas 67202

Lease Name Harkness Well # 1  
Ground surface elevation 2981 GL feet MSL

Well Drilled For: Well Class: Type Equipment:  
X Oil — Storage — Infield X Mud Rotary  
— Gas — Inj X Pool Ext. — Air Rotary  
— OWWO — Expl — Wildcat — Cable

Domestic well within 330 feet: —yes Xno  
Municipal well within one mile: —yes Xno

If OWWO: old well info as follows:

Depth to bottom of fresh water. 200'  
Depth to bottom of usable water 1400' 1200'

Operator N/A  
Well Name  
Comp Date Old Total Depth

Surface pipe by Alternate: 1 2 X  
Surface pipe planned to be set 250'

I certify that well will comply with K.S.A. 55-101, et seq., plus eventually plugging hole to KCC specifications.

Date 8-10-87 Signature of Operator or Agent Kerry D. Parham Title Geologist  
Kerry D. Parham

For KCC Use:


Conductor Pipe Required \_\_\_\_\_ feet; Minimum Surface Pipe Required 220 feet per Alt. X 2  
This Authorization Expires 2-12-88 Approved By Parham 8-12-87

Must be filed with the K.C.C. five (5) days prior to commencing well  
This card void if drilling not started within six (6) months of date received by K.C.C.

### Important procedures to follow:

1. Notify District office before setting surface casing.
2. Set surface casing by circulating cement to the top.
3. File completion forms ACO-1 with K.C.C. within 120 days of well spud date, following instructions on ACO-1, side 1, and including copies of wireline logs.
4. Notify District office 48 hours prior to old well workover or re-entry.
5. Prior to filing Intent, prepare a proposed plugging plan in case well is D & A, then obtain approval of plan when calling district office prior to setting surface pipe.
6. Submit plugging report (CP-4) to K.C.C. after plugging is completed.
7. Obtain an approved injection docket number before disposing of salt water.
8. Notify K.C.C. within 10 days when injection commences or terminates.
9. If an alternate 2 completion, cement in the production pipe from below any usable water to surface within 120 days of spud date.

### A Regular Section of Land 1 Mile = 5,280 Ft.

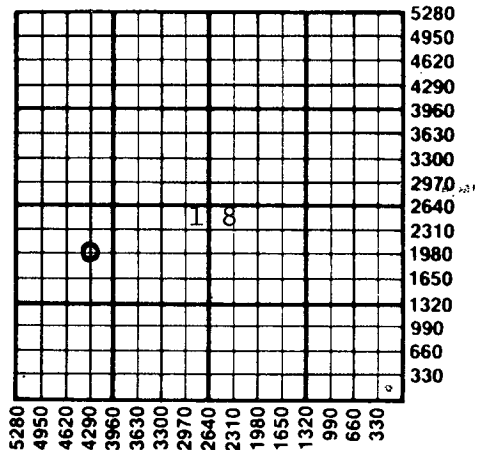

State Corporation Commission of Kansas  
Conservation Division  
200 Colorado Derby Building  
Wichita, Kansas 67202-1212  
(316) 263-3238