

15-169-00466-00-00 SR

STATE OF KANSAS  
STATE CORPORATION COMMISSION


Form CP-4

Give All Information Completely  
Make Required Affidavit  
Mail or Deliver Report to:  
Conservation Division  
State Corporation Commission  
212 No. Market  
Wichita, Kansas 67202

WELL PLUGGING RECORD

Saline County. Sec. 19 Twp. 15 Rge. 3 (E) (W)  
SE SE SE

Location as "NE/CNW/SW" or footage from lines \_\_\_\_\_  
Lease Owner Walter Nelson  
Lease Name Larson #1 Well No. \_\_\_\_\_  
Office Address Salina, Kansas 67401  
Character of Well (completed as Oil, Gas or Dry Hole) \_\_\_\_\_  
Date well completed \_\_\_\_\_ 19\_\_\_\_  
Application for plugging filed \_\_\_\_\_ 19\_\_\_\_  
Application for plugging approved \_\_\_\_\_ 19\_\_\_\_  
Plugging commenced 11/27/71 \_\_\_\_\_ 19\_\_\_\_  
Plugging completed 12/2/71 \_\_\_\_\_ 19\_\_\_\_  
Reason for abandonment of well or producing formation depleted.

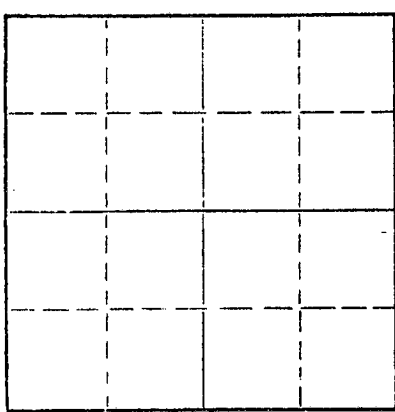

Locate well correctly on above  
Section Plat

If a producing well is abandoned, date of last production \_\_\_\_\_ 19\_\_\_\_  
Was permission obtained from the Conservation Division or its agents before plugging was commenced? yes

Name of Conservation Agent who supervised plugging of this well Toman  
Producing formation \_\_\_\_\_ Depth to top \_\_\_\_\_ Bottom \_\_\_\_\_ Total Depth of Well 3394' Feet  
Show depth and thickness of all water, oil and gas formations.

OIL, GAS OR WATER RECORDS

CASING RECORD

FORMATION	CONTENT	FROM	TO	SIZE	PUT IN	PULLED OUT
				8-5/8	353	none
				5 1/2"	3390'	2737'

Describe in detail the manner in which the well was plugged, indicating where the mud fluid was placed and the method or methods used in introducing it into the hole. If cement or other plugs were used, state the character of same and depth placed, from \_\_\_\_\_ feet to \_\_\_\_\_ feet for each plug set.

Checked bottom, ran sand and 5 sacks of cement. Loaded hole, shot pipe at 2780', worked pipe loose and pulled 85 joints. Bailed hole to 300', set 10' rock bridge, bailed hole down and dumped 4 yards ready mix.

PLUGGING COMPLETE.

RECEIVED  
STATE CORPORATION COMMISSION  
JAN 14 1972  
CONSERVATION DIVISION  
Wichita, Kansas

(If additional description is necessary, use BACK of this sheet)  
Name of Plugging Contractor KNIGHT CASING PULLING CO., INC.  
Address CHASE, KANSAS

STATE OF KANSAS, COUNTY OF RICE, ss.  
NOEL J. KNIGHT (employee of owner) or (owner or operator) of the above-described well, being first duly sworn on oath, says: That I have knowledge of the facts, statements, and matters herein contained and the log of the above-described well as filed and that the same are true and correct. So help me God.

(Signature) [Signature]  
CHASE, KANSAS  
(Address)

6th day of December, 1971

Subscribed and sworn to before me this  
**MARGARET MELCHER**  
NOTARY PUBLIC  
Rice County, Kansas  
My Commission Expires  
Feb. 15, 1975

[Signature]  
Notary Public.

