


STATE OF KANSAS  
STATE CORPORATION COMMISSION

Give All Information Completely  
Make Required Affidavit  
Mail or Deliver Report to:  
Conservation Division  
State Corporation Commission  
P. O. Box 17027  
Wichita, Kansas 67217  
NORTH

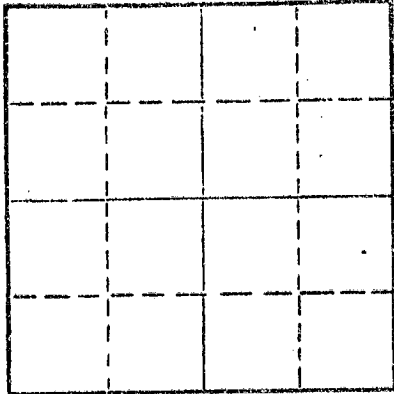

Locate well correctly on above  
Section Plat

Name of Conservation Agent who supervised plugging of this well

Producing formation \_\_\_\_\_ Depth to top \_\_\_\_\_ Bottom \_\_\_\_\_ Total Depth of Well 3410 Feet  
Show depth and thickness of all water, oil and gas formations.

WELL PLUGGING RECORD

15-169-00811-00-00 Form CP-4

Saline \_\_\_\_\_ County, Sec. 19 Twp. 15 Rge. 3 (E) W (W)  
Location as "NE/CNW/SW" or footage from lines. SW NW SW  
Lease Owner: Midwest Supply Company  
Lease Name: Richter Well No. 3  
Office Address: 343 Marmaton Road, El Dorado, Ks 67042  
Character of Well (completed as Oil, Gas or Dry Hole) oil  
Date well completed July 27 19 51  
Application for plugging filed April 3 19 74  
Application for plugging approved April 5 19 74  
Plugging commenced May 31 19 74  
Plugging completed June 4 19 74  
Reason for abandonment of well or producing formation depleted

If a producing well is abandoned, date of last production 19 \_\_\_\_\_  
Was permission obtained from the Conservation Division or its agents before plugging was commenced? yes

Mr. Gilbert Toman

OIL, GAS OR WATER RECORDS

CASING RECORD

FORMATION	CONTENT	FROM	TO	SIZE	PUT IN	PULLED OUT
				8"	159'	none
				5"	3407'	1909.62'

Describe in detail the manner in which the well was plugged, indicating where the mud fluid was placed and the method or methods used in introducing it into the hole. If cement or other plugs were used, state the character of same and depth placed, from \_\_\_\_\_ feet to \_\_\_\_\_ feet for each plug set.

Rig up and dig out cellar. Mixed and dumped 3 sacks of cement at 1900'. Put a 20' rock bridge at 220' to 200' and added 25 sacks of cement. Put a 10' rock bridge at 40' to 30' and added 10 sacks of cement to plug to surface.

RECEIVED  
STATE CORPORATION COMMISSION  
JUN 26 1974  
CONSERVATION DIVISION  
Wichita, Kansas

Name of Plugging Contractor THE BUCKEYE CORPORATION  
Address BOX 1020, EL DORADO, KANSAS 67042

STATE OF KANSAS, COUNTY OF BUTLER, ss.  
Charles V. Cross (employee of owner) or (owner or operator) of the above-described well, being first duly sworn on oath, says: That I have knowledge of the facts, statements, and matters herein contained and the log of the above-described well as filed and that the same are true and correct. So help me God.

(Signature) *Charles V. Cross*


Box 1020, El Dorado, Ks 67042  
(Address)

SUBSCRIBED AND SWORN TO before me this 22nd day of June 1974

*Isa L. Fisher*

Notary Public.

My commission expires \_\_\_\_\_

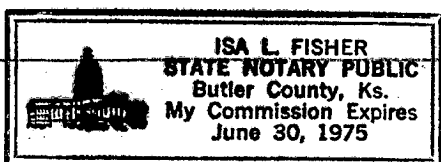

15-169-00811-00-00

MUSGROVE PETROLEUM CORP. # 3 RICHTER

19-15.3W  
SW NW SW

Contr. MUSGROVE PETROLEUM CORPORATION SALINE County

E 1289RB Comm. Comp. 7-27-51 IP 512 BOPD  
PHY POT

Tops	Depth	Datum
VIOLA	3407	-2118
T.D.	3410	-2121

Casing

8" 159 1 BOPH: ACID 1000  
5" 3407 SWB 10 BOPH/5 HRS

SMOLAN POOL

+	+	+
+	+	+
+	+	+

INDEPENDENT OIL & GAS SERVICE  
WICHITA, KANSAS