

15-169-19113-00-00

STATE OF KANSAS
STATE CORPORATION COMMISSION

Form CP-4


Give All Information Completely
Make Required Affidavit
Mail or Deliver Report to:
Conservation Division
State Corporation Commission
211 No. Broadway
Wichita, Kansas

WELL PLUGGING RECORD

Saline County. Sec. 13 Twp. 15 Rge. 3 (E) W (W)
Location as "NE/CNW%SW%" or footage from lines C NE NE
Lease Owner Tom C. Brown
Lease Name Muir Well No. 2
Office Address Lindsborg, Kansas
Character of Well (completed as Oil, Gas or Dry Hole)
Date well completed 19
Application for plugging filed 19
Application for plugging approved 19
Plugging commenced 4-20-64 19
Plugging completed 4-22-64 19
Reason for abandonment of well or producing formation Depleted.

If a producing well is abandoned, date of last production 19
Was permission obtained from the Conservation Division or its agents before plugging was commenced? yes

Name of Conservation Agent who supervised plugging of this well Gilbert Toman
Producing formation Depth to top Bottom Total Depth of Well 3256 Feet
Show depth and thickness of all water, oil and gas formations.

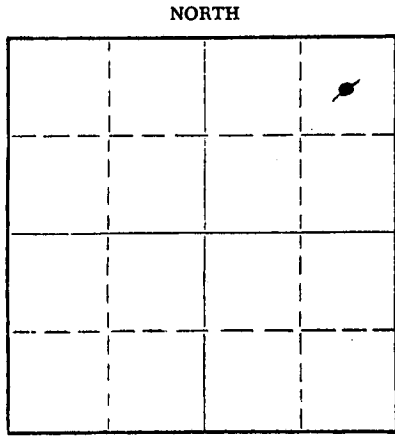

Locate well correctly on above Section Plat

OIL, GAS OR WATER RECORDS

CASING RECORD

FORMATION	CONTENT	FROM	TO	SIZE	PUT IN	PULLED OUT
				8-5/8"	297'	None
				4-1/2"	3254'	2774'

Describe in detail the manner in which the well was plugged, indicating where the mud fluid was placed and the method or methods used in introducing it into the hole. If cement or other plugs were used, state the character of same and depth placed, from feet to feet for each plug set.

Checked hole to 3256', sanded hole to 3240' and dumped 3 sacks of cement @ 3240' with dump bailer. Pulled 4 1/2" casing, bailed hole to 200', set rock bridge to 190' and dumped 20 sacks of cement @ 190' with dump bailer. Mudded hole to 30', set rock bridge and ran 10 sacks of cement to base of cellar.

RECEIVED
STATE CORPORATION COMMISSION

JUN 8 1964

PLUGGING COMPLETE.

CONSERVATION DIVISION
Wichita, Kansas

(If additional description is necessary, use BACK of this sheet)
Name of Plugging Contractor KNIGHT CASING PULLING COMPANY
Address CHASE, KANSAS

STATE OF KANSAS, COUNTY OF RICE, ss.
Noel J. Knight (employee of owner) or (owner or operator) of the above-described well, being first duly sworn on oath, says: That I have knowledge of the facts, statements, and matters herein contained and the log of the above-described well as filed and that the same are true and correct. So help me God.

(Signature) Noel J. Knight
Chase, Kansas
(Address)

SUBSCRIBED AND SWORN TO before me this 24th day of April, 1964

Milton J. Volin
Notary Public.

My commission expires May 20, 1964

15-169-19113-00-00
R

GROUP EXPLORATION COMPANY
Sterling, Kansas

WELL LOG -----MUIR #2
Located: C NE/4 NE/4, Section 13-15S-3W Saline County, Kansas

OWNER: The Mutual Oil Company, Inc.
ROTARY DRILLING CONTRACTOR: Group Exploration Company

COMMENCED: 9-27-61
COMPLETED: 10-1-61

ROTARY TOTAL DEPTH: 3256'

LOG

0 -	70	Shale & Sand	
70 -	298	Lime	
298 -	320	Shale & Lime	
320 -	330	Lime	
330 -	635	Red Bed & Shale	
635 -	765	Fort Riley Lime	
765 -	1880	Shale & Lime	
1880 -	2115	Shale	
2115 -	2465	Lime	
2465 -	2808	Shale & Lime	
2808 -	2910	Lime & Chert Mississippi	
2910 -	3256	Shale & Lime	T.D.

CASING RECORD

Set 8 5/8" Surface
Casing @ 297' with
300 Sacks HA-5 Cement.

Ran 4 1/2" Casing @
3254' with 75 Sacks
Common Cement.

RECEIVED
STATE CORPORATION COMMISSION

APR 17 1964

CONSERVATION DIVISION
Wichita, Kansas