


15-169-00041-0000

STATE OF KANSAS  
STATE CORPORATION COMMISSION

WELL PLUGGING RECORD

Give All Information Completely  
Make Required Affidavit  
Mail or Deliver Report to:  
Conservation Division  
State Corporation Commission  
800 Biting Building  
Wichita, Kansas

NORTH

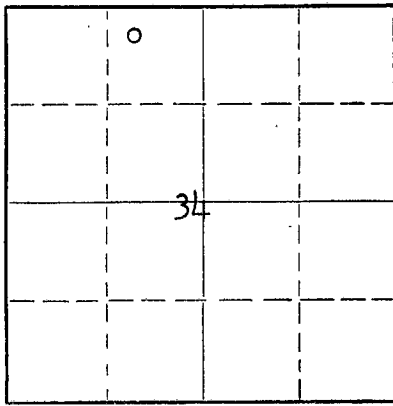

Locate well correctly on above  
Section Plat

Saline County, Sec. 34 Twp. 15S Rge. 3 (WNW) (W)

Location as "NE/CNW/SW" or footage from lines NW NE NW

Lease Owner Phillips & Sanderson

Lease Name Jack K. Fleming Well No. 1

Office Address 535 State St Salina, Kansas

Character of Well (completed as Oil, Gas or Dry Hole) Dry Hole

Date well completed 8-26-54 19

Application for plugging filed 9-6- 1954

Application for plugging approved 9-6- 1954

Plugging commenced 9-6- 1954

Plugging completed 9-6- 1954

Reason for abandonment of well or producing formation Dry Hole

If a producing well is abandoned, date of last production 19

Was permission obtained from the Conservation Division or its agents before plugging was commenced? yes

Name of Conservation Agent who supervised plugging of this well Ruel Durkee

Producing formation none Depth to top Bottom Total Depth of Well 3370 Feet

Show depth and thickness of all water, oil and gas formations.

OIL, GAS OR WATER RECORDS

CASING RECORD

FORMATION	CONTENT	FROM	TO	SIZE	PUT IN	PULLED OUT
Viola	dry	3359	3370	8-5/8"	277'	none

Describe in detail the manner in which the well was plugged, indicating where the mud fluid was placed and the method or methods used in introducing it into the hole. If cement or other plugs were used, state the character of same and depth placed, from feet to feet for each plug set.

Heavy Mud From 3370' to 190'  
 Wood Plug set 190'  
 15 sacks of cement From 190' to 100'  
 Heavy mud From 100' to 35'  
 Wood Plug set 35'  
 5 sacks cement From 35' to 6'  
 Surface soil From 6' to 0'

RECORDED  
 STATE CORPORATION COMMISSION  
 SEP 21 1954  
 CONSERVATION DIVISION

(If additional description is necessary, use BACK of this sheet)

Name of Plugging Contractor J. A. Melland Contractor

Address 1111 N. Main, Hutchinson, Kansas

STATE OF Kansas, COUNTY OF Saline, ss.


T. A. Phillips (employee of owner) or (owner or operator) of the above-described well, being first duly sworn on oath, says: That I have knowledge of the facts, statements, and matters herein contained and the log of the above-described well as filed and that the same are true and correct. So help me God.

(Signature) T. A. Phillips

535 State St., Salina, Kansas (Address)

SUBSCRIBED AND SWORN to before me this 15<sup>th</sup> day of September, 1954

C. B. Dolge, Jr. Notary Public.

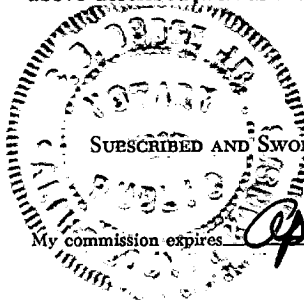

24-2675-6 2-52-20M

PLUGGING  
FILE SEC 34 T 13 R 3W  
BOOK PAGE 61 LINE 32 1

15-169-00041-00-00

W E L L R E C O R D

LEASE NAME Fleming WELL NO. 1 ELEVATION \_\_\_\_\_

LOCATION NW/4 NE/4 NW/4 Section 34-15S-3W, Saline County, Kansas

WORK COMMENCED August 25, 1954 DRILLING COMMENCED August 26, 1954

DRILLING COMPLETED September 6, 1954

DRILLING CONTRACTOR J. A. Melland, 1111 North Main Street, Hutchinson, Kans.

ROTARY DRILLING FROM 0' TO 3370'

GEOLOGIST \_\_\_\_\_

FORMATION	FROM	TO	REMARKS
Surface soil, blue shale & gypsum	0	185	
Shale & anhydrite	185	277	Set and cemented 8-5/8" OD casing at 277' w/ 225 sacks of cement and 2 sacks of calcium chloride. Cement circulated.
Anhydrite	277	285	
Lime & shale	285	310	
Shale & shells	310	490	
Red rock, shale & shells	490	560	
Lime	560	650	
Shale & lime	650	775	
Lime & shale	775	1225	
Shale & shells	1225	1415	
Shale & lime	1415	1735	
Lime	1735	1895	
Lime & shale	1895	2410	
Lime	2410	2515	
Lime & shale	2515	2595	
Shale & lime	2595	2857	
Shale, lime & chert	2857	2920	
Lime & chert	2920	2990	
Lime	2990	3067	
Lime & shale	3067	3131	
Shale & lime	3131	3370	Circulated @ 3300', 1 hr. 24 min. Circulated @ 3365', 1 hr. 7 min. Circulated @ 3370', 1 hr. 13 min.
TOTAL		3370	As no oil or gas was encountered in commercial quantities, regular authority was granted to plug and abandon the well per instructions from Ruel Durkee, S.C.C. well plugger as follows: Heavy mud from 3370' to 190', wood plug set at 190', 15 sacks of cement from 190' to 100', heavy mud from 100' to 35', wood plug set at 35', 5 sacks of cement from 35' to 6', surface soil from 6' to 0', plugged and abandoned September 6, 1954. Slope tests were taken at regular intervals and no deflections from the vertical were recorded.

**PLUGGING**  
 FILE SEC 34 T 15 R 31W  
 BOOK PAGE 61 LINE 32