


WELL PLUGGING RECORD

Give All Information Completely
Make Required Affidavit
Mail or Deliver Report to:
Conservation Division
State Corporation Commission
211 No. Broadway
Wichita, Kansas

NORTH

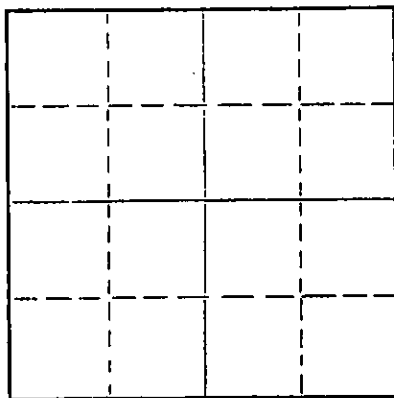

Locate well correctly on above
Section Plat

Saline County, Sec. 20 Twp. 15s Rge. 3 w (E) (W)
Location as "NE/CNW/SW" or footage from lines S 1/2 / E 1/2 / NE 1/4
Lease Owner Frank Vishnefsky
Lease Name Larson Well No. I
Office Address 119 So. Santa Fe, Salina, Kansas
Character of Well (completed as Oil, Gas or Dry Hole) Dry
Date well completed 3/7 1963
Application for plugging filed July 1963
Application for plugging approved July 1963
Plugging commenced Aug 2 1963
Plugging completed Aug 6 1963
Reason for abandonment of well or producing formation Dry

If a producing well is abandoned, date of last production _____ 19____
Was permission obtained from the Conservation Division or its agents before plugging was commenced? Yes

Name of Conservation Agent who supervised plugging of this well Gilbert Toman
Producing formation _____ Depth to top _____ Bottom _____ Total Depth of Well 3374' Feet
Show depth and thickness of all water, oil and gas formations.

OIL, GAS OR WATER RECORDS

CASING RECORD

FORMATION	CONTENT	FROM	TO	SIZE	PUT IN	PULLED OUT
				4 1/2"		2,750'

Describe in detail the manner in which the well was plugged, indicating where the mud fluid was placed and the method or methods used in introducing it into the hole. If cement or other plugs were used, state the character of same and depth placed, from _____ feet to _____ feet for each plug set.

Plugged off bottom of hole with rock, rock from 3351' to 3325'. Dumped 3 sx of cement. Mudded hole to 200'. Made 10' of rock bridge. Dumped 25 sx of cement. Mudded hole to 35'. Made 5' of rock bridge. Dumped 30 sx of cement, filling to the bottom of the celler.

RECEIVED
STATE CORPORATION COMMISSION

AUG 9 1963
08-09-1963

CONSERVATION DIVISION
Wichita, Kansas

(If additional description is necessary, use BACK of this sheet)
Name of Plugging Contractor Art Lamb Casing Pulling Co.
Address P.O. Box 983 Hutchinson, Kansas

STATE OF Kansas, COUNTY OF Reno, ss.
Art Lamb (employee of owner) or (owner or operator) of the above-described well, being first duly sworn on oath, says: That I have knowledge of the facts, statements, and matters herein contained and the log of the above-described well as filed and that the same are true and correct. So help me God.

(Signature) Art Lamb
2809 Kings Dr. Hutchinson, Kansas
(Address)

SUBSCRIBED AND SWORN TO before me this 8 th day of August 1963

My commission expires January 5, 1966
Jeodes Lamb Notary Public.

INVOICED
DATE 8/9/63
INV. NO. 7551-W

15-169-19044-00-00

Larson

WELL NO. 1

SECTION:

Section 20-158-34
Saline County, Kansas

DATE RECORDED: 2/27/63

DATE PLATED: 3/7/63
(10/27/63)

CLIENT: Saline Basin Petroleum Company
119 South Santa Fe
Salina, Kansas

CONTRACTOR: Halland Drilling Company, Inc.
1111 North Main Street
Hutchinson, Kansas

CASING RECORD: 8-5/8" set at 366' with 200 sacks of cement.
4-1/2" set at 337 1/2' with 75 sacks of salt saturated cement.

FORMATION	LOG	
Surface soil and clay and shale	35	
Sand	55	
Shale and shales	268	
Anhydrite	366	
Lime and shale	1075	
Shale with lime shells	1225	
Shale and lime	1622	
Shale and shells	1830	
Lime and shale	1965	
Shale and lime	2243	
Lime and shale	2649	
Shale	2783	
Mississippi Lime	3045	
Lime and shale	3113	
Shale	3236	
Shale and lime	3374	ROUNDED TOTAL DEPTH

STATE OF KANSAS
DEPARTMENT OF REVENUE

APR 9 1963
08-09-1963
COMMISSIONER OF REVENUE