


STATE OF KANSAS
STATE CORPORATION COMMISSION

15-1169-20018-00-00 Form CP-4
WELL PLUGGING RECORD

Give All Information Completely
Make Required Affidavit
Mail or Deliver Report to:
Conservation Division
State Corporation Commission
212 No. Market
Wichita, Kansas

Saline County, Sec. 22 Twp. 15 Rge. 3 (E) (W)

NORTH

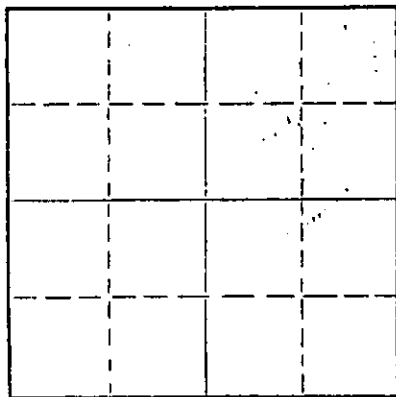

Locate well correctly on above
Section Plat

Location as "NE/CNW/SW" or footage from lines _____
Lease Owner H-30, Inc.
Lease Name Miller #1 Well No. _____
Office Address Hoisington, Kansas
Character of Well (completed as Oil, Gas or Dry Hole) _____
Date well completed _____ 19____
Application for plugging filed _____ 19____
Application for plugging approved _____ 19____
Plugging commenced 6/19/69 _____ 19____
Plugging completed 6/25/69 _____ 19____
Reason for abandonment of well or producing formation depleted.

If a producing well is abandoned, date of last production _____ 19____
Was permission obtained from the Conservation Division or its agents before plugging was commenced? yes

Name of Conservation Agent who supervised plugging of this well Toman
Producing formation _____ Depth to top _____ Bottom _____ Total Depth of Well 3322 Feet
Show depth and thickness of all water, oil and gas formations.

OIL, GAS OR WATER RECORDS

CASING RECORD

FORMATION	CONTENT	FROM	TO	SIZE	PUT IN	PULLED OUT
				8-5/8	301	none
				4 1/2"	3321'	2802'

Describe in detail the manner in which the well was plugged, indicating where the mud fluid was placed and the method or methods used in introducing it into the hole. If cement or other plugs were used, state the character of same and depth placed, from _____ feet to _____ feet for each plug set.

Checked hole to 3322', ran sand to 3300' and set 3 sacks of cement.
Loaded hole, shot pipe at 2895', 2796', ~~plug~~ pulled 86 joints of 4 1/2".
Set rock bridge at 180' and set 25 sacks of cement, mudded hole to 40' and set rock bridge and dumped 10 sacks of cement.

PLUGGING COMPLETE.

RECEIVED
STATE CORPORATION COMMISSION
JUL 7 1969
CONSERVATION DIVISION
Wichita, Kansas
07-07-1969

(If additional description is necessary, use BACK of this sheet)
Name of Plugging Contractor KNIGHT CASING PULLING CO., INC.
Address CHASE, KANSAS

STATE OF KANSAS COUNTY OF RICE, ss.
NOEL J. KNIGHT (employee of owner) or (owner or operator) of the above-described


well, being first duly sworn on oath, says: That I have knowledge of the facts, statements, and matters herein contained and the log of the above-described well as filed and that the same are true and correct. So help me God.

(Signature) Noel Knight
CHASE, KANSAS

(Address)

Subscribed and sworn to before me this 30th day of June, 19 69

My commission expires _____

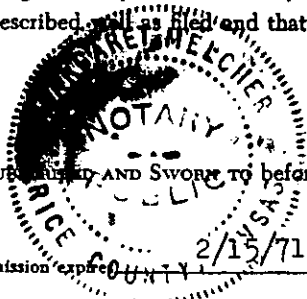

Margaret Melcher
Notary Public.