

15-169-20006-00-00


Give All Information Completely  
Make Required Affidavit  
Mail or Deliver Report to:  
Conservation Division  
State Corporation Commission  
212 No. Market  
Wichita, Kansas

WELL PLUGGING RECORD

Saline County, Sec. 22 Twp. 15 Rge. 3 XXXXXX (W)

Location as "NE/CNWxSWx" or footage from lines C-NE/4 SE/4  
Lease Owner Vandever Petroleum Company  
Lease Name Stroback = Well No. 1  
Office Address 204 Mayo Building, Tulsa, Oklahoma - 74103  
Character of Well (completed as Oil, Gas or Dry Hole) Dry  
Date well completed July 20, 19 67  
Application for plugging filed 19  
Application for plugging approved 19  
Plugging commenced 19  
Plugging completed July 20, 19 67  
Reason for abandonment of well or producing formation Dry Hole

NORTH

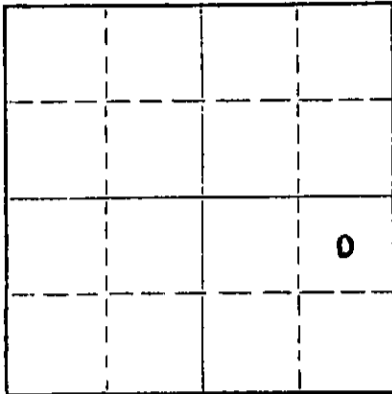

Locate well correctly on above Section Plat

If a producing well is abandoned, date of last production 19  
Was permission obtained from the Conservation Division or its agents before plugging was commenced? Yes

Name of Conservation Agent who supervised plugging of this well Gilbert J. Toman, Holyrood, Kansas  
Producing formation Depth to top Bottom Total Depth of Well Feet  
Show depth and thickness of all water, oil and gas formations.

OIL, GAS OR WATER RECORDS

CASING RECORD

FORMATION	CONTENT	FROM	TO	SIZE	PUT IN	PULLED OUT
Shale & Sand		0	35'	8 5/8"	35'	None
Shale & Shells		35'	157'	8 5/8"	122'	None

Describe in detail the manner in which the well was plugged, indicating where the mud fluid was placed and the method or methods used in introducing it into the hole. If cement or other plugs were used, state the character of same and depth placed, from feet to feet for each plug set.

Set first plug at 150 ft. & put in 20 sacks cement. Filled hole with mud to 40 ft., set second plug, put in 10 sacks cement, 2 sacks in rathole. Job completed at 10:00 P.M., July 20, 1967 by Gilbert J. Toman, State Plugger, Holyrood, Kansas.

(If additional description is necessary, use BACK of this sheet)

Name of Plugging Contractor BLACKSTONE DRILLING, INC.  
Address Box # 455, McPherson, Kansas -- 67460

STATE OF KANSAS, COUNTY OF SALINE, ss.  
J. R. Vandever (employee of owner) or operator of the above-described

well, being first duly sworn on oath, says: That I have knowledge of the facts, statements, and matters herein contained and the log of the above-described well as filed and that the same are true and correct. So help me God.

(Signature) [Signature]

204 Mayo Bldg, Tulsa, Oklahoma-74103  
(Address)

SUBSCRIBED AND SWORN TO before me this 30th day of July, 19 67

My commission expires 11-5-69 [Signature] Notary Public.



15-169-20016-00-00

# Blackstone Drilling, Inc.

Box 455 • 523 West Kansas • Phone CH 1-1250

McPHERSON • KANSAS  
67460

July 24, 1967

COMPANY: VANDEVER PETROLEUM COMPANY  
 CONTRACTOR: BLACKSTONE DRILLING, INC.  
 FARM: STROBACK #1  
 LOCATION: C-NE/4 SE/4, Sec. 22-15-3W,  
 Saline County, Kansas  
 COMMENCED: July 12, 1967  
 COMPLETED: July 20, 1967  
 ELEVATION: 1267 K.B.

0	to	35	Shale & Sand
35	to	300	Shale & Shells
300	to	340	Lime
340	to	950	Lime & Shale
950	to	1700	Shale & Lime
1700	to	1875	Lime
1875	to	2121	Lime & Shale
2121	to	2500	Kansas City
2500	to	2740	Lime & Shale
2740	to	2765	Shale & Lime
2765	to	3000	Mississippi
3000	to	3030	Kinderhook
3030	to	3085	Shale
3085	to	3185	Hunton
3185	to	3328	Shale & Lime
3328	to	3391	Viola Lime
3391	to	3465	Lime
3465	to	3490	Simpson
		3490	T. D.

001-27-176-7

Cut 12 1/4 in. hole to 157 ft. and run 160.65 ft. of 8 5/8 in. O.D. casing and cemented at 157' with 100 sacks cement. Plug down at 2:30 P.M., July 12, 1967. 7 7/8 in. rathole from 157 ft. to 300'. Cut 7 7/8 in. hole to 3490 ft. Hole dry & abandoned. Set first plug at 150 ft. put in 20 sacks cement. Filled hole with mud to 40 ft. set second plug, put in 10 sacks cement. 2 sacks in rathole. Job completed at 10:00 P.M., July 20, 1967 by Gilbert Toman, State Plugger, Holyrood, Kansas.

TOPS: Kansas City - 2121' Mississippi - 2765' Kinderhook - 3030'  
 Hutnon - 3185' Maquoketa - 3276' Viola - 3328' Simpson Sand - 3465'

Measurements taken from K.B.

### CERTIFICATE

I, H. J. Plouffe, President of Blackstone Drilling, Inc. do hereby certify that the above and foregoing is a true and correct copy of log on your Stroback #1, located on the C-NE/4 SE/4 of Sec. 22-15-3W, Saline County, Kansas as reflected by the files of BLACKSTONE DRILLING, INC.

  
 H. J. Plouffe, President

Subscribed and sworn to before me a Notary Public in and for McPherson County, Kansas this 24<sup>th</sup> day of July, 1967.

  
 Ruth McVay - Notary Public



Commission Expires: December 18, 1969.