


Give All Information Completely
Make Required Affidavit
Mail or Deliver Report to:
Conservation Division
State Corporation Commission
800 Bittling Building
Wichita, Kansas

15-169-19040-00-00

WELL PLUGGING RECORD

NORTH

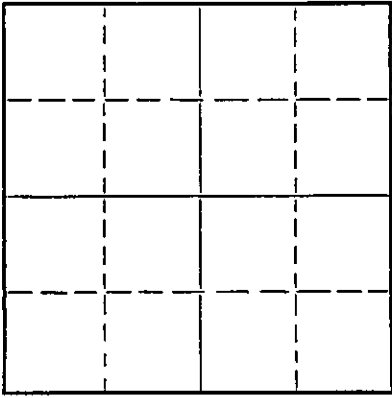

Locate well correctly on above
Section Plat

Saline County. Sec. 17 Twp. 15 Rge. 3 (E) W (W)
Location as "NE/CNW $\frac{1}{4}$ SW $\frac{1}{4}$ " or footage from lines NE NW SE
Lease Owner N. V. Maybrier
Lease Name Percival Well No. 1
Office Address 1120 Greeley, Salina, Kansas
Character of Well (completed as Oil, Gas or Dry Hole) dry hole
Date well completed 8-9-51 19____
Application for plugging filed 8-9-51 19____
Application for plugging approved 8-9-51 19____
Plugging commenced 8-9-51 19____
Plugging completed 8-9-51 19____
Reason for abandonment of well or producing formation no commercial shows

If a producing well is abandoned, date of last production..... 19____
Was permission obtained from the Conservation Division or its agents before plugging was commenced? yes

Name of Conservation Agent who supervised plugging of this well Fuel Durkee
Producing formation..... Depth to top..... Bottom..... Total Depth of Well 3376' Feet
Show depth and thickness of all water, oil and gas formations.

OIL, GAS OR WATER RECORDS

CASING RECORD

Formation	Content	From	To	Size	Put In	Pulled Out
				8 5/8	345'	

Describe in detail the manner in which the well was plugged, indicating where the mud fluid was placed and the method or methods used in introducing it into the hole. If cement or other plugs were used, state the character of same and depth placed, from..... feet to..... feet for each plug set.

Bridged and plugged @ 160' with 15 sx cement and 1 hulls, Plugged at surface with 5 sx cement.

Name of Plugging Contractor Victor Drilling, Inc.
Address 301 Koch Building
Wichita 2, Kansas

STATE OF Kansas, COUNTY OF Sedgwick, ss.
Victor F. Reiserer (employee of owner) or (owner or operator) of the above-described well,
being first duly sworn on oath, says: That I have knowledge of the facts, statements, and matters herein contained and the log of the above-described well as filed and that the same are true and correct. So help me God.

(Signature) Victor F. Reiserer
301 Koch Building, Wichita, Kansas
(Address)

SUBSCRIBED AND SWORN to before me this 13th day of August, 1951
Anna E. Rose
Notary Public.

My commission expires 7-16-55 23-8390-s 6-51-20M

PLUGGING
FILE SEC-17T-15R-3W
BOOK PAGE LINE
19

08-14-1951

15-169-19040-00-00

Opr. N. V. Maybrier #1 Percival Sec. 17-15S-3W

Contr. Victor Drilling, Inc. NE 1/4 SE

Spud: 7-30-51

Comp. 8-9-51

Casing: 8 5/8" @ 342' w/250 sks

clay & gravel	0-342
lime & shale	550
shale & lime	638
lime & shale	760
shale & lime	980
lime & shale	1155
shale & lime	1410
shale	1618
lime & shale	1955
shale & lime	2115
lime & shale	2198
lime	2523
shale	2552
lime	2655
shale & lime	2805
shale	2824
lime	3110
shale & lime	3194
lime & shale	3278
shale	3376 $\frac{1}{2}$
Total Depth	3376 $\frac{1}{2}$

I, Victor F. Reiserer, swear that to the best of my knowledge the foregoing is true.


Victor F. Reiserer
Victor F. Reiserer

STATE OF KANSAS)
) SS
COUNTY OF SEDGWICK)

Subscribed and sworn to before me this 13th day of August, 1951.

Alma E. Ross
Notary Public

My commission expires 7-16-55

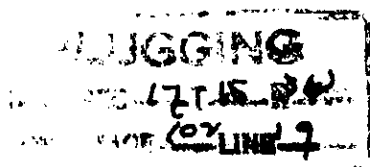

08-14-1951