


WELL PLUGGING RECORD

Give All Information Completely  
Make Required Affidavit  
Mail or Deliver Report to:  
Conservation Division  
State Corporation Commission  
806 Bittling Building  
Wichita, Kansas

Saline County. Sec. 18 Twp. 15 Rge. 3 (E) W (W)  
Location as "NE/CNW $\frac{1}{4}$ /SW $\frac{1}{4}$ " or footage from lines SW SE NE  
Lease Owner Shields Oil Producers  
Lease Name Swanson Well No. 1  
Office Address Box 248, Russell, Kansas  
Character of Well (completed as Oil, Gas or Dry Hole) Dry Hole  
Date well completed 8-5-51 19  
Application for plugging filed 8-5-51 19  
Application for plugging approved 19  
Plugging commenced 8-5-51 19  
Plugging completed 8-6-51 19  
Reason for abandonment of well or producing formation Non Productive  
If a producing well is abandoned, date of last production 19  
Was permission obtained from the Conservation Division or its agents before plugging was commenced? Yes

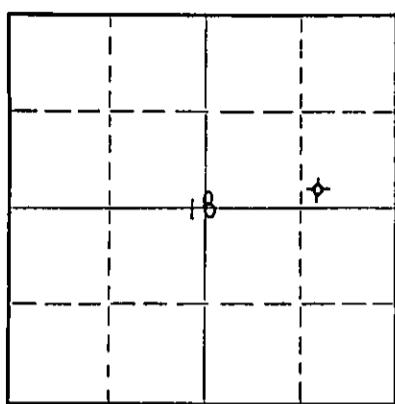

Locate well correctly on above Section Plat

Name of Conservation Agent who supervised plugging of this well Ruel Durkee - Box 597, McPherson, Kansas.  
Producing formation Depth to top Bottom Total Depth of Well 3560 Feet  
Show depth and thickness of all water, oil and gas formations.

OIL, GAS OR WATER RECORDS

CASING RECORD

Formation	Content	From	To	Size	Put In	Pulled Out
Sand Simpson	Water Dry	270 3548	300 3560	8-5/8" Plugged	371'	Cmtd. 450 sax.

Describe in detail the manner in which the well was plugged, indicating where the mud fluid was placed and the method or methods used in introducing it into the hole. If cement or other plugs were used, state the character of same and depth placed, from feet to feet for each plug set.

Broke down 1/2 of drill pipe circ. heavy mud in hole. Broke down the rest of drill pipe and filled hole to 160' with heavy mud, set plug and run 15 sax cement through drill pipe. Filled hole with heavy mud to 15' of top. Set plug and run 5 sax cement.

08-21-1951

(If additional description is necessary, use BACK of this sheet)

Correspondence regarding this well should be addressed to Shields Oil Producers  
Address Box 248  
Russell, Kansas

STATE OF Kansas, COUNTY OF Russell, ss.  
Richard L. Shields, C.O.-Owner (employee of owner) or (owner or operator) of the above-described well, being first duly sworn on oath, says: That I have knowledge of the facts, statements, and matters herein contained and the log of the above-described well as filed and that the same are true and correct. So help me God

(Signature) Richard L. Shields  
Box 248 - Russell, Kansas (Address)

SUBSCRIBED AND SWORN to before me this 20th day of August, 1951

Jo Anne Logsdon Notary Public

My commission expires May 28, 1955

18 15 30  
101 13

15-169-5512-00-00

**SHIELDS OIL PRODUCERS**  
Swanson # 1

SW SE NE  
Sec. 18, T. 15, R. 3W  
Saline County, Kansas

Total Depth: 3560'  
Commenced: July 19, 1951  
Completed: August 5, 1951  
Contractor: Sideo Drilling Co.

**CASING RECORD**

Size	Run	Pulled
8-5/8"	13 Jts.	Cemented w/ 250 sac

Elevation: 1303 D F  
Treatment:  
Production: Dry and  
Abandoned

-----Figures Indicate Bottom of Formation-----

Shale	120	Shale & Shells	1500
Shale & Shells	270	Lime & Shale	1530
Sand	300	Shale & Shells	1700
Broken Lime	324	Lime & Shale	2185
Anhydrite	380	Shale	2205
Shale & Shells	420	Lime	2330
Blue Shale	430	Lime & Shale	2605
Shale & Shells	500	Shale & Shells	2765
Shale & Lime	560	Lime & Shale	2940
Shale Red Bed	580	Lime	3105
Shale & Lime	750	Lime & Chert	3135
Broken Lime	830	Lime & Shale	3185
Lime	870	Shale	3287
Shale & Lime	890	Sandy Lime	3335
Broken Lime	940	Shale & Lime	3404
Shale & Red Rock	970	Lime	3560 T.D.
Lime & Shale	1010		

**NOTES**

TOPS

Br. Lime	2137
Lans.-(KC)	2206
Miss	2837
Mear	3286
Hent	3291
Maq.	3328
Maq. Dol.	3397
Xln Viola	3451
Simpson	3548
T.D.	3560

08-21-1951

SHIELDS OIL PRODUCERS  
FILE 18, T. 15, R. 3W  
BOOK PAGE 01 LINE 13