


WELL PLUGGING RECORD

Give All Information Completely
Make Required Affidavit
Mail or Deliver Report to:
Conservation Division
State Corporation Commission
2400 Broadway
Wichita, Kansas

NORTH

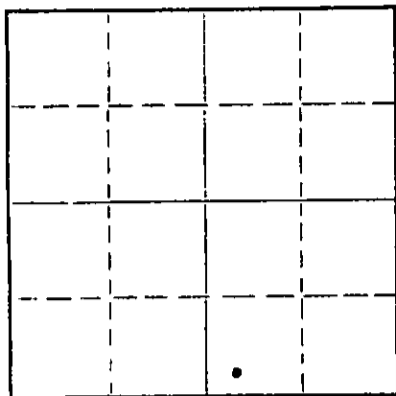

Locate well correctly on above
Section Plat

Saline County, Sec. 16 Twp. 15 Rge. 3 (E) W (W)
Location as "NE/CNW/SW" or footage from lines SW SW SE
Lease Owner Mutual Oil Company, Inc.
Lease Name Schultz Well No. 1
Office Address Salina, Kansas
Character of Well (completed as Oil, Gas or Dry Hole) Dry
Date well completed 19____
Application for plugging filed 19____
Application for plugging approved 19____
Plugging commenced 9-13-62 19____
Plugging completed 9-15-62 19____
Reason for abandonment of well or producing formation Depleted.

If a producing well is abandoned, date of last production 19____
Was permission obtained from the Conservation Division or its agents before plugging was commenced? yes

Name of Conservation Agent who supervised plugging of this well Gilbert Toman
Producing formation None Depth to top Bottom Total Depth of Well 3390 Feet
Show depth and thickness of all water, oil and gas formations.

OIL, GAS OR WATER RECORDS

CASING RECORD

FORMATION	CONTENT	FROM	TO	SIZE	PUT IN	PULLED OUT
Maquoketa	Water	3299	3355	8-5/8"	284'	None
Viola	Water & Heavy oil	3356	3388	5-1/2"	3430'	2656'

Describe in detail the manner in which the well was plugged, indicating where the mud fluid was placed and the method or methods used in introducing it into the hole. If cement or other plugs were used, state the character of same and depth placed, from _____ feet to _____ feet for each plug set.

Checked hole to 3390', sanded to 3340' and dumped 5 sacks of cement @ 3340' with dump bailer. Pulled 5 1/2" casing, checked fluid to 96', bailed fluid to 284', set 15' rock bridge and dumped 3 yards of ready-mix to base of cellar.

RECEIVED
STATE CORPORATION COMMISSION

PLUGGING COMPLETE.

SEP 21 1962
09-21-1962
CONSERVATION DIVISION
Wichita, Kansas

(If additional description is necessary, use BACK of this sheet)
Name of Plugging Contractor KNIGHT CASING PULLING COMPANY
Address CHASE, KANSAS

STATE OF KANSAS, COUNTY OF RICE, ss.
Noel J. Knight (employee of owner) or (operator) of the above-described well, being first duly sworn on oath, says: That I have knowledge of the facts, statements, and matters herein contained and the log of the above-described well as filed and that the same are true and correct. So help me God.

(Signature) Noel J. Knight
Chase, Kansas
(Address)

SUBSCRIBED AND SWORN TO before me this 19th day of September, 1962


My commission expires May 20, 1964

Notary Public.



WELL PLUGGING RECORD

Give All Information Completely
Make required Affidavit
Must Deliver Report to:
Conservation Division
State Corporation Commission
2000 Broadway
Wichita, Kansas

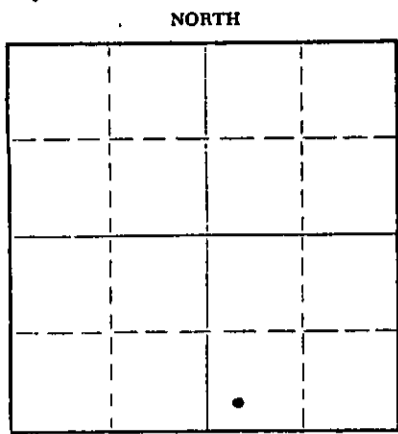

Locate well correctly on above Section Plat

Saline County. Sec. 16 Twp. 15 Rge. 3 (E) W (W)
Location as "NE/CNW&SW" or footage from lines. SW SW SE
Lease Owner Mutual Oil Company, Inc.
Lease Name Schultz Well No. 1
Office Address Salina, Kansas
Character of Well (completed as Oil, Gas or Dry Hole) Dry
Date well completed _____ 19____
Application for plugging filed _____ 19____
Application for plugging approved _____ 19____
Plugging commenced 9-13-62 _____ 19____
Plugging completed 9-15-62 _____ 19____
Reason for abandonment of well or producing formation Depleted.

If a producing well is abandoned, date of last production _____ 19____
Was permission obtained from the Conservation Division or its agents before plugging was commenced? yes

Name of Conservation Agent who supervised plugging of this well Gilbert Toman
Producing formation Oil Depth to top _____ Bottom _____ Total Depth of Well 3390 Feet
Show depth and thickness of all water, oil and gas formations.

OIL, GAS OR WATER RECORDS

CASING RECORD

FORMATION	CONTENT	FROM	TO	SIZE	PUT IN	PULLED OUT
Maquoketa	Water	3299	3355	8-5/8"	284'	None
Viola	Water			5-1/2"	3430'	2656'
	Heavy oil	3356	3360			

Describe in detail the manner in which the well was plugged, indicating where the mud fluid was placed and the method or methods used in introducing it into the hole. If cement or other plugs were used, state the character of same and depth placed, from _____ feet to _____ feet for each plug set.

Checked hole to 3390', sanded to 3340' and dumped 5 sacks of cement @ 3340' with dump bailer. Pulled 5 1/2" casing, checked fluid to 96', bailed fluid to 284', set 15' rock bridge and dumped 3 yards of ready-mix to base of cellar.

RECEIVED
STATE CORPORATION COMMISSION
SEP 21 1962
09-21-1962
CONSERVATION DIVISION
Wichita, Kansas

PLUGGING COMPLETE.

(If additional description is necessary, use BACK of this sheet)
Name of Plugging Contractor KNIGHT CASING PULLING COMPANY
Address CHASE, KANSAS

STATE OF KANSAS, COUNTY OF RICE, ss.
Noel J. Knight (employee of owner) or (owner/proprietor) of the above-described well, being first duly sworn on oath, says: That I have knowledge of the facts, statements, and matters herein contained and the log of the above-described well as filed and that the same are true and correct. So help me God.

(Signature) Noel J. Knight
Chase, Kansas
(Address)

SUBSCRIBED AND SWORN TO before me this 19th day of September, 1962

My commission expires May 20, 1964 Notary Public.

INVOICED
DATE 9/21/62
INV. NO. 5732-W