


Give All Information Completely
Make Required Affidavit
File or Deliver Report to:
Conservation Division
State Corporation Commission
212 North Market, Insurance Bldg.
Wichita, Kansas

WELL PLUGGING RECORD

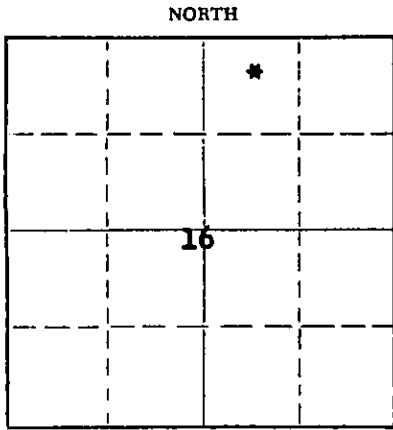

Locate well correctly on above Section Plat

Saline County. Sec. 16 Twp. 15S Rge. (E) 3 (W)
Location as "NE/CNW/SW" or footage from lines N/2 NW/4 NE/4
Lease Owner F. W. Vishnefske
Lease Name Springer-Miller Well No. 1
Office Address 119 South Santa Fe, Saline, Kansas
Character of Well (completed as Oil, Gas or Dry Hole) Dry Hole
Date well completed February 8, 1961
Application for plugging filed 19
Application for plugging approved 19
Plugging commenced February 8, 1961
Plugging completed February 8, 1961
Reason for abandonment of well or producing formation Dry Hole

If a producing well is abandoned, date of last production 19
Was permission obtained from the Conservation Division or its agents before plugging was commenced? Yes

Name of Conservation Agent who supervised plugging of this well Cecil Jones
Producing formation _____ Depth to top _____ Bottom _____ Total Depth of Well 3407 Feet
Show depth and thickness of all water, oil and gas formations.

OIL, GAS OR WATER RECORDS

CASING RECORD

| FORMATION | CONTENT | FROM | TO | SIZE | PUT IN | PULLED OUT |
|-----------|---------|------|----|--------|--------|------------|
| | | | | 8-5/8" | 340' | None |
| | | | | | | |
| | | | | | | |
| | | | | | | |
| | | | | | | |
| | | | | | | |

Describe in detail the manner in which the well was plugged, indicating where the mud fluid was placed and the method or methods used in introducing it into the hole. If cement or other plugs were used, state the character of same and depth placed, from _____ feet to _____ feet for each plug set.

- From 3407' to 300' - Heavy mud
- " 300' to 300' - Set wood plug
- " 300' to 220' - 20 sacks of cement
- " 220' to 35' - Heavy mud
- " 35' to 35' - Set wood plug
- " 35' to 5' - 8 sacks of cement
- " 5' to 0' - Surface soil

03-09-1961

(If additional description is necessary, use BACK of this sheet)

Name of Plugging Contractor Melland Drilling Company, Inc.
Address 1111 North Main Street, Hutchinson, Kansas

STATE OF Kansas, COUNTY OF Saline, ss. _____
(employee of owner) or (owner or operator) of the above-described well, being first duly sworn on oath, says: That I have knowledge of the facts, statements, and matters herein contained and the log of the above-described well as filed and that the same are true and correct. So help me God.

(Signature) F W Vishnefske
119 South Santa Fe, Saline, Kansas
(Address)

SUBSCRIBED AND SWORN TO before me this 8th day of March, 19 61

My commission expires March 15, 1963

Ethel Nystrom
Ethel Nystrom Notary Public.



Le

15-169-00198-00-00

W E L L R E C O R D

LEASE: Springer-Miller WELL NO. 1

LOCATION: N/2 NW/4 NE/4
Section 16-15S-3W
Saline County, Kansas

COMMENCED: 1/30/61

COMPLETED: 2/8/61
(rotary)

OPERATOR: F. W. Vishnefske
119 South Santa Fe
Salina, Kansas

CONTRACTOR: Melland Drilling Company, Inc.
1111 North Main Street
Hutchinson, Kansas

CASING RECORD: 8-5/8" OD set at 340' with 210 sacks of cement.

FORMATION

LOG

| | |
|-----------------------|------|
| Surface soil and clay | 70 |
| Gravel w/ shale | 95 |
| Shale & gravel | 170 |
| Shale w/ lime | 245 |
| Anhydrite | 340 |
| Lime & shale | 920 |
| Shale & lime | 1170 |
| Shale & shells | 1680 |
| Shale & lime | 1890 |
| Shale | 2160 |
| Sand & shale | 2187 |
| Lime & shale | 2325 |
| Lime | 2480 |
| Shale & lime | 2867 |
| Lime & shale | 2973 |
| Mississippi Lime | 2979 |
| Lime | 3021 |
| Lime & shale | 3072 |
| Shale | 3200 |
| Lime & shale | 3225 |
| Lime | 3237 |
| Shale | 3315 |
| Maquoketa | 3335 |
| Lime & shale | 3375 |
| Lime | 3407 |

03-09-1961

ROTARY TOTAL DEPTH
 Flugged back from 3407' to 300'
 w/ heavy mud; set wood plug at
 300'; 20 sacks of cement from 300'
 to 220'; heavy mud from 220' to
 35'; set wood plug at 35'; 8 sacks
 of cement from 35' to 5'; surface
 soil from 5' to 0'. Plugged and
 abandoned 2/8/61.