


15-1109-00683-00-00

WELL PLUGGING RECORD

Give All Information Carefully
 Make Required Affidavit
 Mail or Deliver Report to:
 Conservation Division
 State Corporation Commission
 211 No. Broadway
 Wichita, Kansas

Saline County, Sec. 15 Twp. 15 Rge. (E) 3 (W)

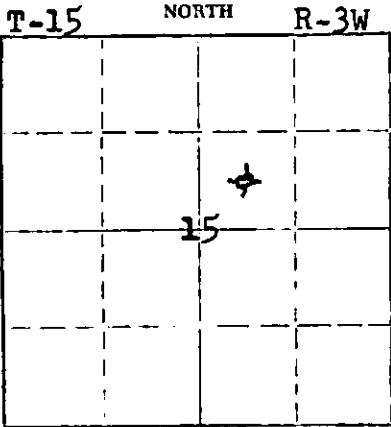

Location as "NE/CNWxSWx" or footage from lines: C SW NE
 Lease Owner: Donald T. Ingling et al
 Lease Name: Bunger Well No. 1
 Office Address: 615 First National Bldg., Wichita 2, Kans.
 Character of Well (completed as Oil, Gas or Dry Hole): Dry Hole
 Date well completed: August 25, 1961
 Application for plugging filed: August 25, 1961
 Application for plugging approved: August 25, 1961
 Plugging commenced: August 26, 1961
 Plugging completed: August 26, 1961
 Reason for abandonment of well or producing formation: Dry

If a producing well is abandoned, date of last production: 19
 Was permission obtained from the Conservation Division or its agents before plugging was commenced? Yes

Name of Conservation Agent who supervised plugging of this well: Cecil Jones
 Producing formation: Depth to top: Bottom: Total Depth of Well: 3333 Feet
 Show depth and thickness of all water, oil and gas formations.

OIL, GAS OR WATER RECORDS

CASING RECORD

FORMATION	CONTENT	FROM	TO	SIZE	PUT IN	PULLED OUT
				8 5/8"	250'	None

Describe in detail the manner in which the well was plugged, indicating where the mud fluid was placed and the method or methods used in introducing it into the hole. If cement or other plugs were used, state the character of same and depth placed, from feet to feet for each plug set.

Circulate heavy mud at total depth, lay down drill pipe except 4 stands, set plug at 240 feet then 20 sacks cement and heavy mud, set plug at 35 feet then 8 sacks cement and heavy mud to surface. 2 sacks cement in rathole.

08-30-1961

(If additional description is necessary, use BACK of this sheet)

Name of Plugging Contractor: Donald T. Ingling
 Address: 615 First National Bldg., Wichita 2, Kansas

STATE OF KANSAS, COUNTY OF SEDGWICK
 D. T. Ingling (employee of owner) or (owner or operator) of the above-described well, being first duly sworn on oath, says: That I have knowledge of the facts, statements, and matters herein contained and the log of the above-described well as filed and that the same are true and correct. So help me God.

(Signature) D. T. Ingling
 615 First National Bldg., Wichita 2 (Address)

SUBSCRIBED AND SWORN TO before me this 29th day of August, 1961

My commission expires Feb. 27, 1964

Notary Public.

15-169-00683-00-00

WELL LOG - BUNGER NO. 1

Donald T. Ingling et al, Lease Owner

Section 15-15-3W

Donald T. Ingling, Contractor

Location: C SW NE

Commenced: 8-16-61

County: Saline

Completed: 8-25-61

Production:

Total Depth: 3333'

Elevation: 1274 RB

Casing: 8 5/8" 250' (175 sacks cement)

Figures below indicate bottom formation

40	clay
70	shale and sand
210	shale and shells
247	lime
250	lime
575	lime
860	lime
1175	shale and shells
1375	shale and shells
1625	lime
1768	lime
1900	lime
2005	lime
2120	lime
2275	lime
2375	lime
2460	lime
2585	lime and shale
2615	lime
2720	shale
2772	shale - Mississippi Top
2821	Mississippi
2905	lime - Mississippi
3010	Mississippi
3065	Mississippi
3160	shale
3211	shale
3260	lime
3313	shale
3320	lime
(3250)	shale - Maquette
3333	lime
3333	Total Depth

STATE CORPORATION COMMISSION
 AUG 30 1961
 08-307961
 CONSERVATION DIVISION
 Wichita, Kansas

I certify this is a true and correct copy of the above mentioned well.

STATE OF KANSAS, COUNTY OF SEDGWICK; ss

Donald T. Ingling

Subscribed and sworn to before me, a Notary Public, in said county and state.

M E Beach
Notary Public

My commission expires: Feb. 27, 1964