

15-169-00216-00-00

WELL PLUGGING RECORD

FORMATION PLUGGING RECORD

Strike out upper line when reporting plugging off formations.

STATE OF KANSAS STATE CORPORATION COMMISSION

Give All Information Completely Make Required Affidavit Mail or Deliver Report to: Conservation Division State Corporation Commission 800 Bitting Building Wichita, Kansas

Saline

County, Sec. 10 Twp. 15 Rge. 3W (E) (W)

Location as "NE1/4NW1/4SW1/4" or footage from lines SE1/4 NE1/4

Lease Owner Northern Ordnance Inc.

Lease Name W. L. Warner

Well No. 1

Office Address Tulsa, Oklahoma

Character of Well (completed as Oil, Gas or Dry Hole) Dry Hole

Date well completed 4-3-43 19

Application for plugging filed 19

Application for plugging approved 19


Plugging commenced 4-4-43 19

Plugging completed 4-4-43 19

Reason for abandonment of well or producing formation Dry hole

If a producing well is abandoned, date of last production 19

Was permission obtained from the Conservation Division or its agents before plugging was commenced? Yes

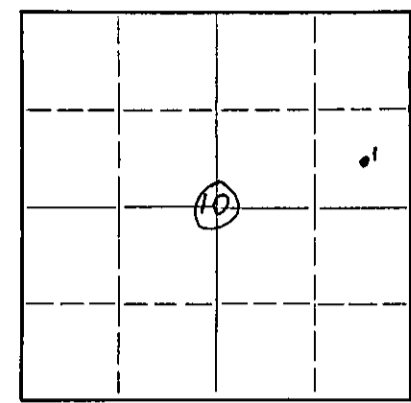

Locate well correctly on above Section Plat

Name of Conservation Agent who supervised plugging of this well Rusl Durkee

Producing formation None Depth to top Bottom Total Depth of Well 3583 Feet

Show depth and thickness of all water, oil and gas formations.

OIL, GAS OR WATER RECORDS

CASING RECORD

Table with 7 columns: Formation, Content, From, To, Size, Put In, Pulled Out. Row 1: None, 10 3/4", 216', None

Describe in detail the manner in which the well was plugged, indicating where the mud fluid was placed and the method or methods used in introducing it into the hold. If cement or other plugs were used, state the character of same and depth placed, from...feet to...feet for each plug set.

Mud 3583 to 216'
Cement 216' to 150' - 35 sax
Mud 15 to 26'
Cement 26 to 6'
Mud 6 to Surface

Handwritten date: 05-12-1943

Handwritten notes: 10, 15, 3W, 69, 20

(If additional description is necessary, use BACK of this sheet)

Correspondence regarding this well should be addressed to E. A. Rose Address Box 786, Great Bend, Kansas

STATE OF Oklahoma, COUNTY OF Tulsa, ss. H. L. Scott

(employee of owner) being first duly sworn on oath, says: That I have knowledge of the facts, statements, and matters herein contained and the log of the above-described well as filed and that the same are true and correct. So help me God.

(Signature) H. L. Scott

1603 Philtower Bldg., Tulsa, Okla. (Address)

SUBSCRIBED AND SWORN to before me this 11th day of May, 1943

E. Lela Walker Notary Public

My commission expires May 4, 1947

15-169-00216-00-00

NORTHERN ORDINANCE INC.
 Center of SE $\frac{1}{4}$, NW $\frac{1}{4}$ Sec. 10 - 15S - 3W
 Saline Co., Kansas
 W. L. WARNER # 1

10 3/4" casing set at 216' and cemented
 with 200 sacks

FORMATION	FROM	TO
Surface clay	0	20
Shale & shells	20	40
Sand	40	50
Blue shale	50	115
Shale	115	170
Gravel	170	180
Blue shale	180	214
Lime	214	218
Broken lime	218	318
Broken lime & shale	318	485
Broken lime	485	1205
Shale & lime	1205	1285
Lime & shale streaks	1285	1400
Broken lime & shale	1400	1485
Lime, hard	1485	1510
Lime & shale	1510	1625
Lime	1625	1680
Broken lime & shale	1680	1770
Broken lime	1770	1895
Lime & shale	1895	2035
Shale & shells	2035	2105
Lime	2105	2170
Shale & lime	2170	2185
Lime	2185	2378
Broken lime	2378	2451
Lime	2451	2507
Shale	2507	2535
Lime & shale	2535	2603
Shale & lime streaks	2603	2671
Shale & lime	2671	2751
Lime	2751	2788
Lime - cherty	2788	2819
Lime	2819	2839
Lime & chert	2839	2938
Cherty lime & shale streaks	2938	2964
Lime	2964	3011
Shale	3011	3157
Lime	3157	3181
Lime broken	3181	3218
Shale & lime	3218	3244
Shale	3244	3293
Lime	3293	3433
Sand	3433	3435
Lime	3435	3447
Shale & lime	3447	3477
Sand & shale	3477	3480
Sand hard	3480	3485
Cherty lime	3485	3498
Lime	3498	3583

05-12-1943

101.15.3W
 69.1.15.20