


Give All Information Completely
Make Required Affidavit
Mail or Deliver Report to:
Conservation Division
State Corporation Commission
211 No. Broadway
Wichita, Kansas

WELL PLUGGING RECORD

Greeley County, Sec. 12 Twp. 20S Rge. (E) 40 (W)

Location as "NE/CNW/SW" or footage from lines NW NW
Lease Owner Earl F. Wakefield
Lease Name Donnelly Well No. 1-12
Office Address 515 Union Center Bldg., Wichita, Kansas
Character of Well (completed as Oil, Gas or Dry Hole) Dry Hole
Date well completed March 16 19 66
Application for plugging filed 7 March 16 19 66
Application for plugging approved March 16 19 66
Plugging commenced March 16 19 66
Plugging completed March 16 19 66
Reason for abandonment of well or producing formation Dry Hole

NORTH

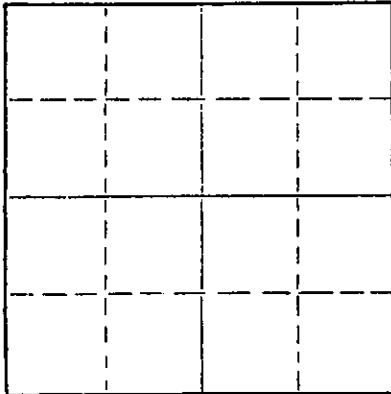

Locate well correctly on above
Section Plat

If a producing well is abandoned, date of last production 19
Was permission obtained from the Conservation Division or its agents before plugging was commenced? Yes

Name of Conservation Agent who supervised plugging of this well W. L. Nichols
Producing formation Depth to top Bottom Total Depth of Well 2915 Feet
Show depth and thickness of all water, oil and gas formations.

OIL, GAS OR WATER RECORDS

CASING RECORD

| FORMATION | CONTENT | FROM | TO | SIZE | PUT IN | PULLED OUT |
|-----------|---------|------|----|--------|--------|------------|
| | | | | 8 5/8" | 302' | None |
| | | | | | | |
| | | | | | | |
| | | | | | | |
| | | | | | | |
| | | | | | | |
| | | | | | | |
| | | | | | | |

Describe in detail the manner in which the well was plugged, indicating where the mud fluid was placed and the method or methods used in introducing it into the hole. If cement or other plugs were used, state the character of same and depth placed, from feet to feet for each plug set.

Filled with Mud from 2915' to 650'
20 sacks cement from 650' to 575'
Filled with mud from 575' to 300'
20 Sacks cement from 300' to 230'
Filled with mud from 230' to 40'
10 Sacks cement from 40' to Surface

RECEIVED
STATE CORPORATION COMMISSION

MAR 30 1966

CONSERVATION DIVISION
WICHITA, KANSAS

(If additional description is necessary, use BACK of this sheet)

Name of Plugging Contractor Earl F. Wakefield
Address 515 Union Center Building, Wichita, Kansas 67202

STATE OF KANSAS, COUNTY OF SEDGWICK, ss. Fred S. Barker

(employee of owner) or (REGISTERED) of the above-described well, being first duly sworn on oath, says: That I have knowledge of the facts, statements, and matters herein contained and the log of the above-described well as filed and that the same are true and correct. So help me God.

(Signature) Fred S. Barker
515 Union Center Building, Wichita
(Address)

SUBSCRIBED AND SWORN TO before me this 29th day of March, 19 66

My commission expires January 25, 1969
Wanda W. Riley Notary Public.

DRILLER'S LOG

15-071-30053-0000

LEASE: DONNELLY NO. 1-12
OWNER: EARL F. WAKEFIELD
CONT: EARL F. WAKEFIELD
COMM: 3-11-66
COMP: 3-14-66

LOCATION: NW NW
SECTION 12-208-40W
GREELEY COUNTY, KANSAS
CASING: 8 5/8" SET @ 302'
T.D. @ 2915' D & A

ELEVATION: 3558' G.L.

| | |
|-----------------|------|
| Surface Soil | 30 |
| Sand & Clay | 125 |
| Blue Shale | 303 |
| Shells & Clay | 1233 |
| Shale | 1454 |
| Anhydrite | 1468 |
| Shale & Shells | 1575 |
| Shale & Red Bed | 1850 |
| Salt | 2110 |
| Shale & Shells | 2390 |
| Shale & Lime | 2442 |
| Anhydrite | 2460 |
| Lime & Shale | 2730 |
| Lime | 2915 |
| P.T.D. | 2915 |
| Log T.D. | 2915 |

RECEIVED
STATE CORPORATION COMMISSION

MAR 30 1966

CONSERVATION DIVISION
Wichita, Kansas

STATE OF KANSAS)
) SS
COUNTY OF SEDGWICK)

I, FRED S. BARKER, DO HEREBY CERTIFY THAT THE ABOVE IS A TRUE AND CORRECT COPY OF THE DRILLER'S LOG ON THE DONNELLY #1-12, LOCATED NW NW OF SECTION 12-208-40W, GREELEY COUNTY, KANSAS.

EARL F. WAKEFIELD

BY Fred S. Barker
Fred S. Barker

SUBSCRIBED AND SWORN TO BEFORE ME THIS 29TH DAY OF MARCH, 1966.

MY COMMISSION EXPIRES:
JANUARY 25, 1969

Wanda W. Riley
WANDA W. RILEY :::: NOTARY PUBLIC