15-169-19012-00-00

Pd. 10/29/37 HA

OCT 29 1937

83-11

STATE OF KANSAS
STATE CORPORATION COMMISSION

Give All Information Completely
Make Required Affidavit
Mail or Deliver Report to:
Conservation Division
State Corporation Commission
800 Bitting Building
Wichita, Kansas

WELL PLUGGING RECORD
OR
FORMATION PLUGGING RECORD

Strike out upper line when reporting plugging off formations.

NORTH

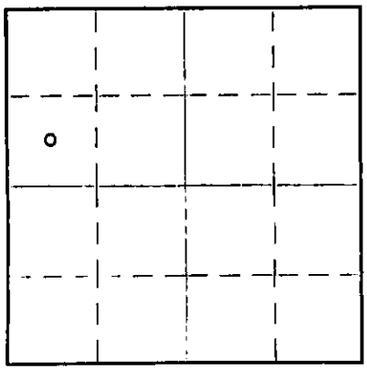

Locate well correctly on above Section Plat

SALINE County. Sec. 28 Twp. 14S Rge. (E) 2 (W)

Location as "NE¼NW¼SW¼" or footage from lines SW NW NW

Lease Owner Ryan Consolidated Petroleum Corp. et al

Lease Name Huerth Well No. 1

Office Address 1021 Thompson Building

Character of Well (Completed as Oil, Gas or Dry Hole) Dry Hole

Date, well completed April 3, 1937.

Application for plugging filed April 3, 1937.

Application for plugging approved 193

Plugging Commenced April 4, 1937.

Plugging Completed April 9, 1937.

Reason for abandonment of well or producing formation Dry Hole

If a producing well is abandoned, date of last production 193

Was permission obtained from the Conservation Division or its agents before plugging was commenced? Yes

Name of Conservation Agent who supervised plugging of this well C. D. Russell

Producing formation Depth to top Bottom Total Depth of Well 3415 Feet.

Show depth and thickness of all water, oil and gas formations.

OIL, GAS OR WATER RECORDS — CASING RECORD

Formation	Content	From	To	Size	Put In	Pulled Out
Lime	Water	1995	2015	15-1/2"	188'	188'
Sandy Lime	Water	2063	2070	13-3/8"	1014'	1014'
Lime	Water	2230	2240	10"	2299'	2299'
Lime	Water	2735	2740	8-5/8"	3120'	3120'
Lime	Show Oil	3305	3313	6-5/8"	3260'	3260'
Lime	Water	3405	3415			

Describe in detail the manner in which the well was plugged, indicating where the mud fluid was placed and the method or methods used in introducing it into the hole. If cement or other plugs were used, state the character of same and depth placed, from feet to feet for each plug set.

Filled with mud to 2500 feet; bridged at 200 feet and set 15 foot cement plug. Bridged at 20 feet and filled with mud and cement to bottom of cellar and capped with cement.

Pd. 10/29/37 HA

28 14 2W
83 11

(If additional description is necessary, use BACK of this sheet)

Correspondence regarding this well should be addressed to Ryan Consolidated Petroleum Corporation

Address 1021 Thompson Building - Tulsa, Oklahoma

STATE OF Oklahoma, COUNTY OF Tulsa, ss.

Watson B. Joyes (employee of owner) or (owner or operator) of the above-described well, being first duly sworn on oath, says: That I have knowledge of the facts, statements, and matters herein contained and the log of the above-described well as filed and that the same are true and correct. So help me God.

(Signature) Watson B. Joyes
President
1021 Thompson Building - Tulsa, Oklahoma
(Address)

SUBSCRIBED AND SWORN TO before me this 28 day of October, 1937.

G. L. Hango
Notary Public.

My commission expires 7-22-39.

17-932 9-37—5M