


STATE OF KANSAS
STATE CORPORATION COMMISSION

Give All Information Completely
Make Required Affidavit
Mail or Deliver Report to:
Conservation Division
State Corporation Commission
211 No. Broadway
Wichita, Kansas

15-169-19070-00-00 Form CP-4
WELL PLUGGING RECORD

NORTH

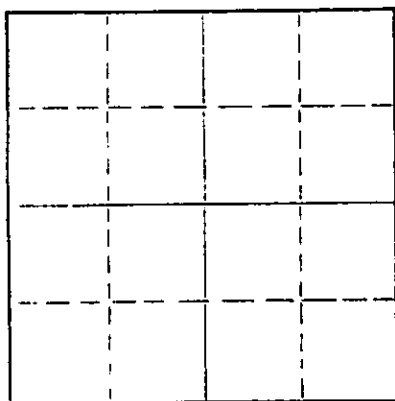

Locate well correctly on above
Section Plat

Saline County. Sec. 6 Twp. 15 Rge. (E) 2 (W)
Location as "NE/CNW/SW" or footage from lines. NW SW
Lease Owner Don Ingling
Lease Name Needels Well No. #2
Office Address 615 First Nat'l Bldg. Wichita, Kans.
Character of Well (completed as Oil, Gas or Dry Hole) dry hole
Date well completed 5/28 1962
Application for plugging filed 5/28 1962
Application for plugging approved 5/28 1962
Plugging commenced 5/28 1962
Plugging completed 5/28 1962
Reason for abandonment of well or producing formation dry hole

If a producing well is abandoned, date of last production 19
Was permission obtained from the Conservation Division or its agents before plugging was commenced? yes

Name of Conservation Agent who supervised plugging of this well Cecil Jones
Producing formation Depth to top Bottom Total Depth of Well 3250 Feet
Show depth and thickness of all water, oil and gas formations.

OIL, GAS OR WATER RECORDS

CASING RECORD

FORMATION	CONTENT	FROM	TO	SIZE	PUT IN	PULLED OUT
				8 5/8	220'	
				4 1/2	32 1/4'	1400'

Describe in detail the manner in which the well was plugged, indicating where the mud fluid was placed and the method or methods used in introducing it into the hole. If cement or other plugs were used, state the character of same and depth placed, from feet to feet for each plug set.

Wooden plug with wires at 215 ft.
Bridged with rock to 200 ft.
25 sx. cement, mud & rock to 15 ft.
with 5 sx. cement to top.

RECEIVED
STATE CORPORATION COMMISSION

AUG 12 1962

08-16-62

CONSERVATION DIVISION

(If additional description is necessary, use BACK of this sheet)

Name of Plugging Contractor WHITE & ELLIS DRILLING, INC. License #209
Address Box 448 El Dorado, Kans.

STATE OF Kansas, COUNTY OF Butler, ss.
Ernest Sifford, employee of contractor (Signature) of the above-described well, being first duly sworn on oath, says: That I have knowledge of the facts, statements, and matters herein contained and the log of the above-described well as filed and that the same are true and correct. So help me God.

(Signature) Ernest Sifford

Box 448 El Dorado, Kansas
(Address)

SUBSCRIBED AND SWORN TO before me this 15th day of August, 19 62

L. B. Gunt

My commission expires September 26, 1964

Notary Public.

15-169-19070-00-00

WELL LOG - NEEDLES NO. 2

Donald T. Ingling et al, Lease Owner

Section 6-15-2W

Donald T. Ingling, Contractor

Location: NW SW

Commenced: 3-17-62

County: Saline

Completed: 3-25-62

Production:

Total Depth: 3247 (rotary)

Elevation: 1253 RB

Casing: 8 5/8" 220' (150 sacks cement)
4 1/2" 3244' (50 sacks cement)


Figures below indicate bottom formation

35 surface clay
 90 sand
 160 shale and shells
 220 lime
 515 lime
 650 lime
 800 lime and shale
 1075 lime and shale
 1435 lime and shale
 1675 lime and shale
 1850 lime
 2010 lime
 2150 lime
 2255 lime
 2400 lime
 2515 lime and shale
 2610 lime
 2697 lime and shale
 2790 Mississippi
 2918 Mississippi
 2990 shale
 3070 shale
 3160 lime
 3220 shale
 3240 shale
 3247 Maquoketa dolomite
 3247 Total Depth

I certify this is a true and correct copy of the above mentioned well.

STATE OF KANSAS)
) ss.
 SEDGWICK COUNTY)

Subscribed and sworn to before me, a Notary Public, in said county and state.


 Notary Public

My commission expires: 2-27-64