


STATE OF KANSAS  
STATE CORPORATION COMMISSION

WELL PLUGGING RECORD

Give All Information Completely  
Make Required Affidavit  
Mail or Deliver Report to:  
Conservation Division  
State Corporation Commission  
212 No. Market  
Wichita, Kansas

Saline County, Sec. 6 Twp. 15 Rge. (E) 2 (W)

Location as "NE/CNW/SW" on footage from lines S10 S10 SE  
Lease Owner Donald T. Inaling, et al  
Lease Name Altman Well No. 1  
Office Address 615 1st Natl. Bldg., Wichita, Kans.  
Character of Well (completed as Oil, Gas or Dry Hole) Oil  
Date well completed April 22, 1961  
Application for plugging filed April 3, 1967  
Application for plugging approved April 6, 1967  
Plugging commenced April 18, 1967  
Plugging completed April 20, 1967  
Reason for abandonment of well or producing formation Production below economic limit  
If a producing well is abandoned, date of last production April 30, 1965  
Was permission obtained from the Conservation Division or its agents before plugging was commenced? Yes

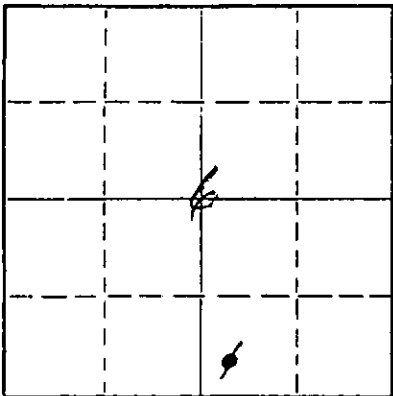

Locate well correctly on above Section Plat

Name of Conservation Agent who supervised plugging of this well Gilbert Toman  
Producing formation Maquoketa dolomite Depth to top 3227 Bottom 3234 Total Depth of Well 3234 Feet  
Show depth and thickness of all water, oil and gas formations.

OIL, GAS OR WATER RECORDS

CASING RECORD

FORMATION	CONTENT	FROM	TO	SIZE	PUT IN	PULLED OUT
				8 5/8"	270'	none
				5 1/2"	3232'	2609'

Describe in detail the manner in which the well was plugged, indicating where the mud fluid was placed and the method or methods used in introducing it into the hole. If cement or other plugs were used, state the character of same and depth placed, from \_\_\_\_\_ feet to \_\_\_\_\_ feet for each plug set.

*Fitted back with gravel to 3220'. Dumped 5 sacks of cement. Shot pipe off at 2609.60'. Pulled pipe and mudded hole to 300'. Set 10' rock bridge at 300'. Finished with 3 yards of ready mix cement.*

RECEIVED  
STATE CORPORATION COMMISSION

MAY 14 1967

CONSERVATION DIVISION  
WICHITA, KANSAS

Name of Plugging Contractor Bert Self (If additional description is necessary, use BACK of this sheet)  
Address Hutchinson, Kans.

STATE OF Kans. COUNTY OF Reno SS.  
Employee (Bert Self) (employee of owner) or (owner or operator) of the above-described well, being first duly sworn on oath, says: That I have knowledge of the facts, statements, and matters herein contained and the log of the above-described well as filed and that the same are true and correct. So help me God.

(Signature) Bert Self  
R. R. #4, Hutchinson, Kans. (Address)

SUBSCRIBED AND SWORN TO before me this 24th day of April, 1967

My commission expires October 18, 1967 Lorothy Seitz Notary Public.

WELL LOG - ALTMAN NO. 1

15-169-19069-00-00

Donald T. Ingling et al, Lease Owner

Section 6-15-2W

Donald T. Ingling, Contractor

Location: SW SW SE

Commenced: 3-30-61

County: Saline

Completed: 4-8-61

Production:

Total Depth: 3233' (rotary)

Elevation: 1248 RB

Casing: 8 5/8" 270' (160 sacks cement)  
5 1/2" 3232' (40 sacks cement)

Figures below indicate bottom formation

15	surface clay
60	sand
133	shale
270	lime
380	lime
650	lime
880	lime
915	lime
1270	shale and shells
1590	shale and shells
1715	lime
1880	lime and shale
1935	shale
2100	shale
2215	lime
2330	lime
2360	lime
2460	shale and lime
2600	shale and lime
2680	shale
2745	lime
2855	lime
2894	Mississippi
2934	shale
3055	shale and lime streaks
3075	shale and lime
3165	lime
3225	shale
3232	shale
3233	dolomite
3233	Total Depth

RECEIVED  
 APR 5 1967  
 CONSERVATION DIVISION  
 Wichita, Kansas

I certify this is a true and correct copy of the above mentioned well.

STATE OF KANSAS )  
 SEDGWICK COUNTY ) ss.

Donald T. Ingling

Subscribed and sworn to before me, a Notary Public, in said county and state

W. E. Black  
 Notary Public

My commission expires: Feb. 27, 1964