

STATE OF KANSAS
STATE CORPORATION COMMISSION

WELL PLUGGING RECORD

Give All Information Completely
Make Required Affidavit
Mail or Deliver Report to:
Conservation Division
State Corporation Commission
211 No. Broadway
Wichita, Kansas

Saline County. Sec. 6 Twp. 15 Rge. (E) 2 (W)

Location as "NE/CNWxSWx" or footage from lines SW SW

Lease Owner Donald T. Ingling et al

Lease Name Needels Well No. 1

Office Address Wichita, Kansas

Character of Well (completed as Oil, Gas or Dry Hole) Oil

Date well completed June 19, 19 61

Application for plugging filed March 19 65

Application for plugging approved March 30, 19 65


Plugging commenced March 30, 19 65

Plugging completed April 8 19 65

Reason for abandonment of well or producing formation Production declined below economic limit

If a producing well is abandoned, date of last production December 19, 19 64

Was permission obtained from the Conservation Division or its agents before plugging was commenced? Yes

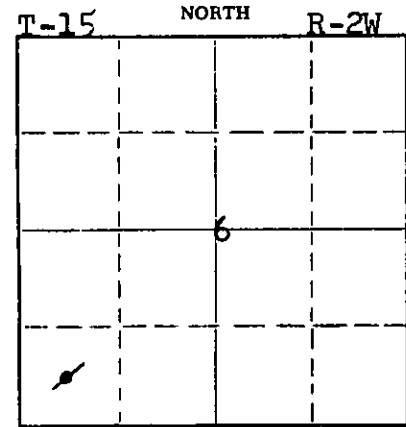

Locate well correctly on above Section Plat

Name of Conservation Agent who supervised plugging of this well Gilbert Toman

Producing formation Maquoketa dol. Depth to top 3240 Bottom Total Depth of Well 3247 Feet

Show depth and thickness of all water, oil and gas formations.

OIL, GAS OR WATER RECORDS

CASING RECORD

FORMATION	CONTENT	FROM	TO	SIZE	PUT IN	PULLED OUT
				8 5/8"	230	none
				4 1/2"	3242 1/2	2530

Describe in detail the manner in which the well was plugged, indicating where the mud fluid was placed and the method or methods used in introducing it into the hole. If cement or other plugs were used, state the character of same and depth placed, from _____ feet to _____ feet for each plug set.

Filled back in the 4 1/2" with rock and gravel and dumped 3 sacks of cement. Shot pipe off at 2530'. Pulled pipe and mudded hole to 250'. Set rock bridge and finished filling surface with ready mix cement

RECEIVED
STATE CORPORATION COMMISSION

MAY 19 1965
1965

CONSERVATION DIVISION
Wichita, Kansas

(If additional description is necessary, use BACK of this sheet)

Name of Plugging Contractor Bert Self

Address Hutchinson, Kansas

STATE OF KANSAS, COUNTY OF SEDGWICK, ss.

D. T. Ingling (employee of owner) or (owner or operator) of the above-described well, being first duly sworn on oath, says: That I have knowledge of the facts, statements, and matters herein contained and the log of the above-described well as filed and that the same are true and correct. So help me God.

(Signature) *D. T. Ingling*

615 First Nat'l Bldg., Wichita, Kans
(Address)

SUBSCRIBED AND SWORN TO before me this 12th day of April, 19 65

M. E. Black

My commission expires Feb. 27, 1968

Notary Public.

WELL LOG - NEEDLES NO. 1

15-164-00212-00-00

Donald T. Ingling et al, Lease Owner

Section 6-15-2W

Donald T. Ingling, Contractor

Location: C SW SW

Commenced: 5-10-61

County: Saline

Completed: 5-20-61

Production:

Total Depth: 3245 (rotary)

Elevation: 1255 RB

Casing: 8 5/8" 230' (150 sacks cement)

4 1/2" 3242 1/2' (60 sacks cement)

Figures below indicate bottom formation

40 surface clay
80 sand
150 shale
180 lime
230 lime
450 lime and shale streaks
555 lime
625 lime
825 lime
945 lime
1125 shale and lime
1400 shale and shells
1615 shale and lime
1835 lim3
1890 lime
2000 shale
2125 lime
2220 lime
2345 lime
2465 lime and shale
2505 lime
2530 shale
2692 shale
2700 Mississippi
2785 Mississippi - cherty
2915 lime
2916 Mississippi
2955 shale
3040 shale
3075 shale
3120 lime
3165 lime
3195 shale
3240 shale
3243 lime
3245 lime
3245 Total Depth

RECEIVED
STATE CORPORATION COMMISSION

MAY 19 1961

CONSERVATION DIVISION
Wichita, Kansas

I certify this is a true and correct copy of the above mentioned well.

STATE OF KANSAS)
) ss.
SEDGWICK COUNTY)

Donald T. Ingling

Subscribed and sworn to before me, a Notary Public, in said county and state.

My commission expires: Feb. 27. 1964

McBlack