

15-169-19025-00-00


STATE OF KANSAS
STATE CORPORATION COMMISSION

Form CP-4

WELL PLUGGING RECORD

Give All Information Completely
Make Required Affidavit
Mail or Deliver Report to:
Conservation Division
State Corporation Commission
212 No. Market
Wichita, Kansas

Saline County. Sec. 6 Twp. 15 Rge. 2 (E) (W)
Location as "NE/CNW/SW" or footage from lines SW NE
Lease Owner H-30, Inc.
Lease Name Gaywood Well No. 1
Office Address Wichita, Kansas
Character of Well (completed as Oil, Gas or Dry Hole) _____
Date well completed _____ 19____
Application for plugging filed _____ 19____
Application for plugging approved _____ 19____
Plugging commenced 1/7/67 _____ 19____
Plugging completed 1/11/67 _____ 19____
Reason for abandonment of well or producing formation depleted.

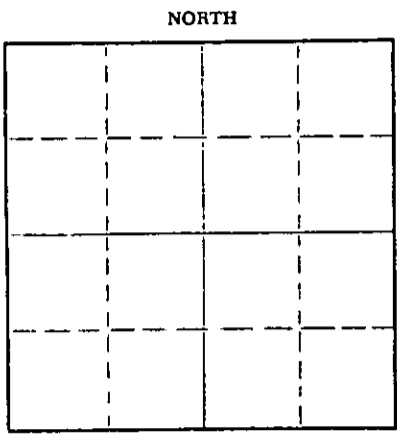

Locate well correctly on above
Section Plat

If a producing well is abandoned, date of last production _____ 19____
Was permission obtained from the Conservation Division or its agents before plugging was commenced? yes

Name of Conservation Agent who supervised plugging of this well Gib Toman
Producing formation _____ Depth to top _____ Bottom _____ Total Depth of Well 3233 Feet
Show depth and thickness of all water, oil and gas formations.

OIL, GAS OR WATER RECORDS


CASING RECORD

FORMATION	CONTENT	FROM	TO	SIZE	PUT IN	PULLED OUT
				8 5/8	206	none
				1/2	3230	2533

Describe in detail the manner in which the well was plugged, indicating where the mud fluid was placed and the method or methods used in introducing it into the hole. If cement or other plugs were used, state the character of same and depth placed, from _____ feet to _____ feet for each plug set.

Raised mast, checked bottom, ran sand to 3220', dumped 3 sacks of cement. Cleaned cellar. Rigged up on 4 1/2", had 20" tension. Loaded hole, shot pipe at 2927', 2861', 2765'. Worked pipe up to 36" tension. Shot pipe 2632', shot pipe 25.32 pipe came loose, pulled 65 joints of 4 1/2" casing. Pulled 13 joints of 4 1/2", cleared floor. Loaded junk rack, bailed hole to 190', set 10' rock bridge. Dumped 20 sacks cement. Mudded to 40' rock bridge and capped hole with 10 sacks of cement. Racked unit, tallied pipe.

PLUGGING COMPLETE.

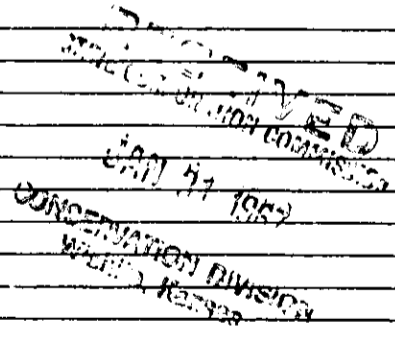

(If additional description is necessary, use BACK of this sheet)

Name of Plugging Contractor KNIGHT CASING PULLING COMPANY
Address CHASE, KANSAS

STATE OF KANSAS, COUNTY OF RICE, ss.

NOEL J. KNIGHT (employee of owner) or (owner or operator) of the above-described well, being first duly sworn on oath, says: That I have knowledge of the facts, statements, and matters herein contained and the log of the above-described well as filed and that the same are true and correct. So help me God.

(Signature) Noel J. Knight
CHASE, KANSAS
(Address)

SUBSCRIBED AND SWORN TO before me this 16 day of Jan, 1967

My commission expires Oct 22-1970
[Signature] Notary Public.

State of Kansas, County of _____

15-169-19025-2W

1/4 NE/4

1/4 NE/4























RECEIVED
STATE CORPORATION COMMISSION

DEC 29 1936

CONSERVATION DIVISION
Wichita, Kansas

I certify this is a true and correct copy of the above mentioned well.

STATE OF KANSAS

SEDCRICK COUNTY

Subscribed and sworn to before me this _____ day of _____, 1936.

W. B. ...
Notary Public

My commission expires _____