

15-169-19064-00-01

STATE OF KANSAS
STATE CORPORATION COMMISSION

Form CP-4


Give All Information Completely
Make Required Affidavit
Mail or Deliver Report to:
Conservation Division
State Corporation Commission
212 No. Market
Wichita, Kansas

WELL PLUGGING RECORD

Saline County. Sec. 6 Twp. 15 Rge. (E) 2 (W)

Location as "NE/CNW/SW" or footage from lines SW SE SW
Lease Owner Donald T. Ingling, et al
Lease Name Altman Well No. 3
Office Address 615 First National Bldg., Wichita, Kans.
Character of Well (completed as Oil, Gas or Dry Hole) dry hole 1929; reopened SW disposal hole Dec. 1961
Date well completed January 2, 1962
Application for plugging filed April 3, 1967
Application for plugging approved April 6, 1967
Plugging commenced April 27, 1967
Plugging completed April 27, 1967
Reason for abandonment of well or producing formation no further production this lease

NORTH R2W

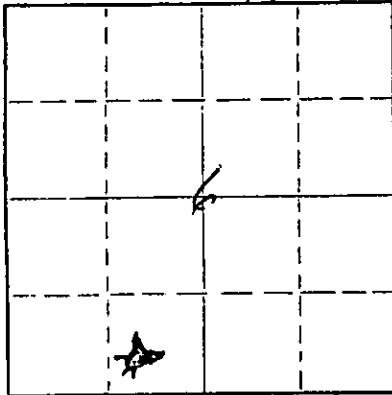

Locate well correctly on above Section Plat

If a producing well is abandoned, date of last production _____ 19____
Was permission obtained from the Conservation Division or its agents before plugging was commenced? yes Gilbert Toman

Name of Conservation Agent who supervised plugging of this well _____
Producing formation _____ Depth to top _____ Bottom _____ Total Depth of Well 3505 Feet
Show depth and thickness of all water, oil and gas formations.

OIL, GAS OR WATER RECORDS

CASING RECORD

| FORMATION | CONTENT | FROM | TO | SIZE | 1929 PUT IN | PULLED OUT |
|-----------|---------|------|----|--------|----------------|------------|
| | | | | 20" | 145' | none |
| | | | | 4 1/2" | 3465' | 794' |
| | | | | | | |
| | | | | | | |
| | | | | | | |
| | | | | | | |

Describe in detail the manner in which the well was plugged, indicating where the mud fluid was placed and the method or methods used in introducing it into the hole. If cement or other plugs were used, state the character of same and depth placed, from _____ feet to _____ feet for each plug set.

Filled back in the 4 1/2 with gravel and dumped 3 sacks of cement. Shot pipe off at 794.35'. Pulled pipe. (could not knock out bridge at 75) Filled hole with 6 yards of ready mix cement.

RECEIVED
STATE CORPORATION COMMISSION

JUL 14 1967

CONSERVATION DIVISION
Wichita, Kansas

Name of Plugging Contractor Bert Self (If additional description is necessary, use BACK of this sheet)
Address Hutchinson, Kans.

STATE OF Kans. COUNTY OF Reno, ss.
Employee (Bert Self) (employee of owner) or (owner or operator) of the above-described well, being first duly sworn on oath, says: That I have knowledge of the facts, statements, and matters herein contained and the log of the above-described well as filed and that the same are true and correct. So help me, God.

(Signature) Bert Self
R. R. #4, Hutchinson, Kans.
(Address)

SUBSCRIBED AND SWORN TO before me this 1st day of May, 19 67

My commission expires October 18, 1967

Notary Public.

15-169-17004-00 8015

WELL LOG - ALTMAN NO. 3

Donald T. Ingling et al, Lease Owner

Section 6-15-2W

Donald T. Ingling, Contractor

Location: SW SE SW

Commenced: 12-4-61
Completed: 12-18-61

County: Saline

Production:

Total Depth: 3505


Elevation: 1257'

Casing: (well originally drilled by Dixie Oil Co., Inc., Sept. 11, 1929 to 3442 ft. and they set 145 feet of surface pipe (20") - other strings of pipe run pulled out - then called Henry Mair #1)

4 3/8" 3465' (125 sacks cement)

Figures below indicate bottom formation

3460 Simpson sand
3475 Arbuckle lime
3505 Arbuckle lime
3505 Total Depth

 

I certify this is a true and correct copy of the above mentioned well.

D. T. Ingling

STATE OF KANSAS, COUNTY OF SEDGWICK: ss

Subscribed and sworn to before me, a Notary Public, in said county and state.

M. E. Black
Notary Public

My commission expires: Feb. 27, 1964