

15-169-19074-00-00

STATE OF KANSAS
STATE CORPORATION COMMISSION


Form CP-4

WELL PLUGGING RECORD

Give All Information Completely
Make Required Affidavit
Mail or Deliver Report to:
Conservation Division
State Corporation Commission
212 No. Market
Wichita, Kansas

Saline County, Sec. 5 Twp. 15 Rge. 2 (E) X (W)
Location as "NE/CNWxSWx" or footage from lines SW SW SW
Lease Owner Solar Oil Co.
Lease Name Schoffner Well No. #1
Office Address 1117 Union National Bldg., Wichita, Kansas
Character of Well (completed as Oil, Gas or Dry Hole)
Date well completed 19____
Application for plugging filed 19____
Application for plugging approved 19____
Plugging commenced 8-5-66 19____
Plugging completed 8-8-66 19____
Reason for abandonment of well or producing formation _____

NORTH

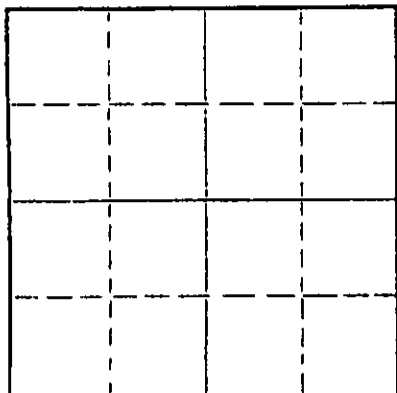

Locate well correctly on above
Section Plat

If a producing well is abandoned, date of last production 19____
Was permission obtained from the Conservation Division or its agents before plugging was commenced? _____

Name of Conservation Agent who supervised plugging of this well Gilbert Toman
Producing formation _____ Depth to top _____ Bottom _____ Total Depth of Well 3218' Feet
Show depth and thickness of all water, oil and gas formations.

OIL, GAS OR WATER RECORDS

CASING RECORD

FORMATION	CONTENT	FROM	TO	SIZE	PUT IN	PULLED OUT

Describe in detail the manner in which the well was plugged, indicating where the mud fluid was placed and the method or methods used in introducing it into the hole. If cement or other plugs were used, state the character of same and depth placed, from _____ feet to _____ feet for each plug set.

Made bottom hole plug back with sand to 3200', mixed and ran 5 sacks cement thru dump bailer.
Mudded hole to 300', set 15' rock bridge. Filled hole with 3 3/4 yards ready mix from 285' to base of cellar.

RECEIVED
STATE CORPORATION COMMISSION
AUG 11 1966
CONSERVATION DIVISION
WICHITA, KANSAS

(If additional description is necessary, use BACK of this sheet)
Name of Plugging Contractor Southwest Casing Pulling Co., Inc.
Address Box 364, Great Bend, Kansas

STATE OF Kansas, COUNTY OF Barton, ss.
Southwest Casing Pulling Co., Inc. (employee of owner) or (owner or operator) of the above-described well, being first duly sworn on oath, says: That I have knowledge of the facts, statements, and matters herein contained and the log of the above-described well as filed and that the same are true and correct. So help me God.

(Signature) W. C. Spencer
Box 364, Great Bend, Kansas
(Address)

SUBSCRIBED AND SWORN TO before me this 8 day of August, 1966

My commission expires 24 October 1968

Sidney D. Miller
Notary Public.

DRILLER LOG

Company: Solar Oil Company
 Farm: Schoffner # 1
 Commenced: June 19, 1961

SW SW SW Section 5-15-2W
 Saline County, Kansas
 Completed: June 27, 1961

Elevation:

.....

0 - 60	sand
60 - 80	shale
80 - 275	lime & shale
275 - 435	lime
435 - 600	lime & shale
600 - 1970	shale & lime
1970 - 2053	shale
2053 - 2415	lime
2415 - 2731	lime & shale
2731 - 2870	Mississippi
2870 - 2924	lime & shale
2924 - 3039	shale
3039 - 3217	lime
3217	Total Depth

RECEIVED
 STATE CORPORATION COMMISSION
 JUL 27 1966
 CONSERVATION DIVISION
 WICHITA, KANSAS

Set 80 feet of 13 3/8 inch conductor pipe, cemented with 105 sacks of cement with 22 gal and 42 calcium chloride. Set 275 feet of 8 5/8 inch surface pipe, cemented with 210 sacks of cement with 22 gal and 22 calcium chloride.

Tops: Kansas City - 2053
 Mississippi - 2731
 Nequahota - 3211

Set 3217 feet of 5 1/2 inch casing, cemented with 75 sacks of cement.

A F F I D A V I T

STATE OF KANSAS)
) SS
 COUNTY OF BARTON)

I, Allan Hays of the Burns-Burt Drilling Company being first duly sworn on oath state: I have knowledge of the facts, statements and matters herein contained and the same are true and correct.

Allan Hays

Subscribed and sworn to before me this 7 day of July, 1961.

Mary E. Van Belt
 Notary Public

My commission expires January 20, 1962.