


STATE OF KANSAS
STATE CORPORATION COMMISSION

Give All Information Completely
Make Required Affidavit
Mail or Deliver Report to:
Conservation Division
State Corporation Commission
211 No. Broadway
Wichita, Kansas

15-169-00208-00-00
WELL PLUGGING RECORD

NORTH

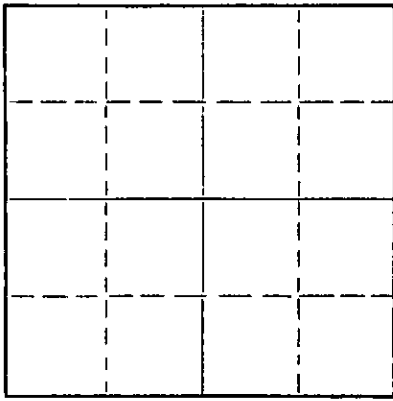

Locate well correctly on above
Section Plat

Saline County. Sec 5 Twp 15S Rge. 2 (E) 2 (W)
Location as "NE/CNW/SW" or footage from lines. NE NW SE
Lease Owner DeWeese & Sanderson
Lease Name Sudendorf Well No. 1
Office Address Box 811, Salina, Kansas
Character of Well (completed as Oil, Gas or Dry Hole) Dry Hole
Date well completed 8/30 1957
Application for plugging filed 8/30 1957
Application for plugging approved 8/30 1957
Plugging commenced 8/30 1957
Plugging completed 8/30 1957
Reason for abandonment of well or producing formation Dry Hole

If a producing well is abandoned, date of last production _____ 19____
Was permission obtained from the Conservation Division or its agents before plugging was commenced? Yes

Name of Conservation Agent who supervised plugging of this well _____
Producing formation _____ Depth to top _____ Bottom _____ Total Depth of Well 3430 Feet
Show depth and thickness of all water, oil and gas formations.

OIL, GAS OR WATER RECORDS

CASING RECORD

FORMATION	CONTENT	FROM	TO	SIZE	PUT IN	PULLED OUT
				8-5/8	222	None

Describe in detail the manner in which the well was plugged, indicating where the mud fluid was placed and the method or methods used in introducing it into the hole. If cement or other plugs were used, state the character of same and depth placed, from _____ feet to _____ feet for each plug set.

Good solid plug at bottom of surface pipe with 15 sacks cement.
Good solid plug at top of surface pipe with 5 sacks cement.

(If additional description is necessary, use BACK of this sheet)

Name of Plugging Contractor Greenland Drilling Company
Address 4722 Broadway, Kansas City 12, Mo.

STATE OF Kansas, COUNTY OF Sedgwick, ss.
Oscar Bridge, Vice-Pres. of Greenland Drlg. Co. (employee of owner) or (owner or operator) of the above-described well, being first duly sworn on oath, says: That I have knowledge of the facts, statements, and matters herein contained and the log of the above-described well as filed and that the same are true and correct. So help me God.

(Signature) Oscar Bridge Vice-President
Greenland Drilling Company, 4722 Broadway, KC12Mo.
(Address)

SUBSCRIBED AND SWORN TO before me this 5th day of September, 1957

Verdina B. Rutledge
Notary Public.

My commission expires March 15, 1960

PLUGGING
FILE SEC 5 T. 15 R. 2W
BOOK PAGE 42 LINE 13

9-9-57

WELL LOG

Company: De Weese & Sanderson

Sec. 5 Twp. 15S Rge. 2W
Location: NE NW SE
Saline County, Kansas

Farm: SUDENDORF No. 1

Commenced: 8/19/57

Completed: 8/30/57

Total Depth: 3430

Contractor: GREENLAND DRILLING COMPANY

Casing: 8-5/8" 222'
5-1/2" ---Elevation:
Production: D & A

Figures Indicate Bottom of Formations

	Rock	TOPS:
20		
175	Shale & lime	
222	Lime	
252	Lime & shale	
435	Lime	
740	Lime & shale	
1580	Shale & lime	
1675	Lime & shale	
2050	Shale & lime	
2360	Lime & shale	
2685	Shale & lime	
2950	Miss.	
3060	Shale & lime	
3111	Lime and Shale	
3259	Shale & lime	
3279	Lime & chert	
3323	Lime	
3325	Viola Lime	
3360	Lime & shale	
3392	Lime & shale	
3430	Simpson	
3430	RTD.	

STATE OF KANSAS, COUNTY OF SEDGWICK, ss:

I, Oscar Bridge, of the Greenland Drilling Company, upon oath state that the above and foregoing is a true and correct copy of the log of the #1 Sudendorf well.

Oscar Bridge
Oscar Bridge, Vice-President

Subscribed and sworn to before me this 5th day of September, 1957.

My commission expires March 15, 1960.

Verdina B. Rutledge
Verdina B. Rutledge, Notary Public

PLUGGING	
FILE	SEC 5 T 15 R 2W
BOOK	PAGE 42 LINE 13

RECORDED
STATE CORP.

SEP 10 1957

NOTARY PUBLIC