


OR  
FORMATION PLUGGING RECORD

Strike out upper line when reporting plugging off formations.

Give All Information Completely  
Make Required Affidavit  
Mail or Deliver Report to:  
Conservation Division  
State Corporation Commission  
800 Blitting Building  
Wichita, Kansas

NORTH

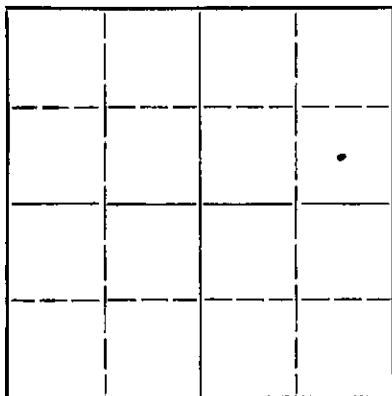

Locate well correctly on above Section Plat

Scott County. Sec. 15 Twp. 20S Rge. (E) 33 (W)  
Location as "NE¼NW¼SW¼" or footage from lines. C of SE of NE  
Lease Owner. Shallow Water Refining Co.  
Lease Name. Mary Vaniman Well No. 1  
Office Address. 114 W. Pine Garden City, Kansas  
Character of Well (completed as Oil, Gas or Dry Hole). Oil  
Date well completed. Febr. 12, 19. 35  
Application for plugging filed. Oct. 5, 19. 48  
Application for plugging approved. Oct. 6, 19. 48  
Plugging commenced. Oct. 19, 19. 48  
Plugging completed. Dec. 21, 19. 48  
Reason for abandonment of well or producing formation. Non commercial  
If a producing well is abandoned, date of last production. Sept. 8, 19. 48  
Was permission obtained from the Conservation Division or its agents before plugging was commenced? Yes.

Name of Conservation Agent who supervised plugging of this well. C.D. Stough  
Producing formation. Mississippi Depth to top. 4637 Bottom. 4722 Total D. [REDACTED]  
Show depth and thickness of all water, oil and gas formations.

OIL, GAS OR WATER RECORDS

CASING RECORD

Formation	Content	From	To	Size	Put In	Pulled Out
Mississippi	Crude Oil	4637	4722	15 1/2"	243'	0
				10 3/4"	4014'	1395.72'
				8 5/8"	4564'	3760.33'
				7" Liner	127.3"	0

Describe in detail the manner in which the well was plugged, indicating where the mud fluid was placed and the method or methods used in introducing it into the hold. If cement or other plugs were used, state the character of same and depth placed, from \_\_\_\_\_ feet to \_\_\_\_\_ feet for each plug set.

Drove wooden plug into top of 7" liner @ 4553'  
Dumped 10 sacks cement on 10' rock bridge @ 4553'  
Mud to 3716'  
Drove wooden plug into top of 8 5/8" pipe @ 3716'  
Dumped 10 sacks of cement on 10' rock bridge @ 3716'  
Mud to 245'  
Dumped 50 sacks of cement on 10' rock bridge @ 245'  
Mud 10'  
10 sacks cement on top for cap.

(If additional description is necessary, use BACK of this sheet)

Correspondence regarding this well should be addressed to. Shallow Water Refining Co.  
Address. 114 W. Pine Garden City, Kansas

STATE OF Kansas, COUNTY OF Finney, ss.  
Employee of owner (employee of owner) or (owner or operator) of the above-described well,

being first duly sworn on oath, says: That I have knowledge of the facts, statements, and matters herein contained and the log of the above-described well as filed and that the same are true and correct. So help me God.

(Signature) Ben F. Kelly  
Scott City, Kansas (Address)

SUBSCRIBED AND SWORN to before me this 11th day of January, 1949

My commission expires December 1, 1951

George Paddock  
Notary Public.

22-287 7-47-10M  
**PLUGGING**  
FILE SEC 15 T 20 R 33  
BOOK PAGE 66 LINE 29