

15-171-43341-00-00

STATE OF KANSAS
STATE CORPORATION COMMISSION


Give All Information Completely
Make Required Affidavit
Mail or Deliver Report to:
Conservation Division
State Corporation Commission,
800 Bitting Building,
Wichita, Kansas

6-28-37
JUN 28 1937

WELL PLUGGING RECORD
OR
FORMATION PLUGGING RECORD

Strike out upper line
when reporting plug-
ging off formations.

NORTH

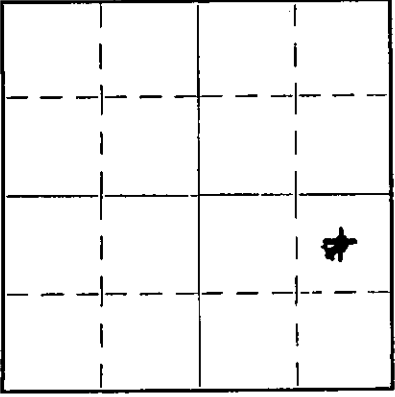

Locate well correctly on above
Section Plat

SCOTT County. Sec. 15 Twp. 20S Rge. (E) 33 (W)

Location as "NE1/4NW1/4SW1/4" or footage from lines Cen. NE SE
Lease Owner. Atlantic Refining Co.
Lease Name. Marks C-1 Well No. C-1
Office Address. Box 17, Great Bend, Kansas
Character of Well (Completed as Oil, Gas or Dry Hole) Dry Hole
Date, well completed. June, 16 19. 7
Application for plugging filed. June, 16 193. 7
Application for plugging approved. June, 16 193. 7
Plugging Commenced. June, 16 193. 7
Plugging Completed. June, 16 193. 7
Reason for abandonment of well or producing formation Dry hole

If a producing well is abandoned, date of last production. 193.
Was permission obtained from the Conservation Division or its agents before plugging was com-
menced? Yes

Name of Conservation Agent who supervised plugging of this well. Mr. C. T. Alexander
Producing formation. none Depth to top. Bottom. Total Depth of Well. 5490' Feet
Show depth and thickness of all water, oil and gas formations.

OIL, GAS OR WATER RECORDS

CASING RECORD

Formation	Content	From	To	Size	Put In	Pulled Out
Top of K.C.		3987		13"	258'	
Top of Miss.		4656				
Top of Sil.		5470				
Water		5470	5490			

Describe in detail the manner in which the well was plugged, indicating where the mud fluid was placed and the method or methods used in introducing it into the hole. If cement or other plugs were used, state the character of same and depth placed, from.....feet to.....feet for each plug set.

Twenty sacks cement in bottom of surface pipe at 250' and surface pipe was filled with mud layden fluid, last twenty feet was plugged with thirty sacks cement. Hole below surface pipe was filled with 11# mud.

PLUGGED
FILE 15 20 2300
BOOK 94 28

(If additional description is necessary use BACK of this sheet)

Correspondence regarding this well should be addressed to. Dewey A. Jordan
Address. Box 17, Atlantic Refining Co.
Great Bend, Kansas.

STATE OF....., COUNTY OF....., ss.

(employee of owner) or (owner or operator) of the above-described well,
being first duly sworn on oath, says: That I have knowledge of the facts, statements, and matters herein contained and the log of the above-described well as filed and that the same are true and correct. So help me God.

(Signature) Dewey A. Jordan
Box 17, Great Bend,
Kansas
(Address)

SUBSCRIBED AND SWORN to before me this 23^d day of Nov. 13-1939
My commission expires.....

19. 37
Dewey A. Jordan
Notary Public.

<u>FORMATION</u>	<u>TOP</u>	<u>BOTTOM</u>	<u>FORMATION</u>	<u>TOP</u>	<u>BOTTOM</u>
Surface Clay	0	30	Broken Lime & Shale	4589	4656
Shale	30	70	Lime	4656	4674
Sand	70	85	Coring lime	4674	4677
Shale	85	120	Coring	4677	4685
Sand	120	190	Lime	4685	4696
Lime	190	205	Coring	4696	4697
Shale	205	265	Lime	4697	4818
Shale & Shells	265	320	Hard lime	4818	4823
Shale	320	530	Lime	4823	4864
Shale & Shells	530	740	Coring lime	4864	4874
Shale	740	780	Lime	4874	4896
Shale & Shells	780	900	Lime & Shale	4896	4902
Lime	900	920	Lime	4902	4913
Shale	920	1110	Core	4913	4923
Lime & Shale	1110	1135	Lime	4923	5143
Shale & Shells	1135	1155	Lime & Chert	5143	5168
Red Bed	1155	1185	Lime	5168	5175
Red Bed, Shale	1185	1290	Lime & Shale	5175	5195
Shale	1290	1330	Lime	5195	5352
Red Bed, Shale	1330	1380	Lime & Chert	5352	5398
Shale	1380	1430	Lime	5398	5478
Lime	1430	1460	Core lime	5478	5490 T.D.
Red Bed	1460	1505			
Shale & Lime	1505	1525			
Lime	1525	1550			
Lime & Shale	1550	1590			
Red Bed	1590	2000			
Shale & Shells	2000	2065			
Red Bed	2065	2120			
Lime	2120	2135			
Shale & Red Bed	2135	2160			
Shale	2160	2175			
Lime	2175	2220			
Red Bed & lime shells	2220	2425			
Lime	2425	2475			
Shale	2475	2485			
Lime	2485	2570			
Lime & Shale	2570	2620			
Lime	2620	2650			
Shale	2650	2705			
Lime	2705	2735			
Lime & Shale	2735	2740			
Shale	2740	2805			
Lime	2805	2815			
Lime & Shale	2815	2840			
Shale	2840	2910			
Lime & Shale	2910	2930			
Shale & Shells	2930	2960			
Lime	2960	2985			
Lime & Shale	2985	3000			
Shale & Lime Shells	3000	3025			
Lime	3025	3095			
Lime & Shale	3095	3135			
Lime	3135	3164			
Shale	3164	3214			
Lime	3214	3264			
Shale	3264	3295			
Lime	3295	3335			
Lime & Shale	3335	3365			
Shale	3365	3390			
Shale, Lime, Shells	3390	3411			
Lime	3411	3960			
Shale	3960	3987			
Sticky Shale	3987	3993			
Lime	3993	4058			
Lime & Shale	4058	4070			
Lime	4070	4253			
Hard lime	4253	4270			
Lime & Shale	4270	4278			
Lime	4278	4314			
Shale	4314	4340			
Lime, Shale, Shells	4340	4369			
Lime	4369	4391			
Lime & Shale	4391	4400			
Shale	4400	4415			
Shale & Shells	4415	4435			
Lime	4435	4589			

15-171-43341-00-00

Atlantic

Marks C #1

re se 15-20-33W

Scott Co.

Atlantic will notify
Alex.

94-28

Hol