

STATE OF KANSAS
STATE CORPORATION COMMISSION
Give All Information Completely
Make Required Affidavit
Mail or Deliver Report to:
Conservation Division
State Corporation Commission
800 Blitting Building
Wichita, Kansas


WELL PLUGGING RECORD

OR

FORMATION PLUGGING RECORD

Strike out upper line
when reporting plug-
ging off formations.

NORTH

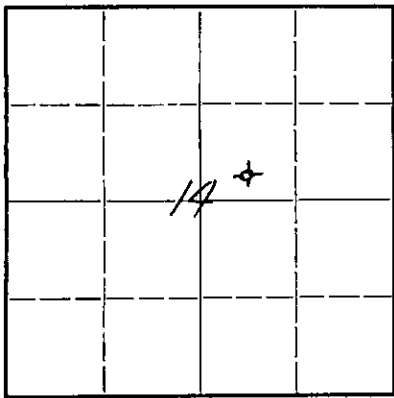

Locate well correctly on above
Section Plat

Scott County. Sec. 14 Twp. 20 Rge. (E) 33 (W)
Location as "NE $\frac{1}{4}$ NW $\frac{1}{4}$ SW $\frac{1}{4}$ " or footage from lines 330'N & 660'E SWcorner $\frac{1}{4}$
Lease Owner Penn Electric Switch Co., Goshen, Indiana.
Lease Name Minnie Dague Well No. 1
Office Address % Frank R. Young, Box 372, Scott City, Kans.
Character of Well (completed as Oil, Gas or Dry Hole) Dry hole
Date well completed March 6, 1945. 19
Application for plugging filed Feb. 12, 1945. 19
Application for plugging approved Feb. 14, 1945. 19
Plugging commenced March 5, 1945 19
Plugging completed March 6, 1945. 19
Reason for abandonment of well or producing formation Produced only a show
of oil after shooting and acidizing.
If a producing well is abandoned, date of last production none 19
Was permission obtained from the Conservation Division or its agents before plugging was com-
menced? Yes

Name of Conservation Agent who supervised plugging of this well Mr. Kerr.
Producing formation Mississippi lime Depth to top 4610 Bottom 4705 Total Depth of Well 4705 Feet
Show depth and thickness of all water, oil and gas formations.

OIL, GAS OR WATER RECORDS

CASING RECORD

Formation	Content	From	To	Size	Put In	Pulled Out
Surface sand and shale	Fresh water	160	163	8 $\frac{1}{2}$ "OD	645	0
Mississippi lime	slight show oil	4610	4705	5 $\frac{1}{2}$ "OD	4600	1601'10"
(See drillers log affidavit attached)						

Describe in detail the manner in which the well was plugged, indicating where the mud fluid was placed and the method or methods used in introducing it into the hold. If cement or other plugs were used, state the character of same and depth placed, from.....feet to.....feet for each plug set.

Put 15 sacks cement in bottom to reach up into the 5 $\frac{1}{2}$ " casing. Mudded hole to bottom of surface pipe and put 15 sacks cement in bottom of surface pipe. Filled surface pipe with mud and put 10 sacks cement in top.

(If additional description is necessary, use BACK of this sheet)

Correspondence regarding this well should be addressed to Frank R. Young,
Address Box 372,
Scott City, Kansas.

STATE OF Kansas COUNTY OF Scott
Frank R. Young (employee of owner) or (owner or operator) of the above-described well,
being first duly sworn on oath, says: That I have knowledge of the facts, statements, and matters herein contained and the log of the above-described well as filed and that the same are true and correct. So help me God.

(Signature)

Box 372 Scott City, Kans.
(Address)

SUBSCRIBED AND SWORN to before me this 3rd day of April 1945.

My commission expires

Jan 1, 1946.

Notary Public.

COPY

15-171-43332 00-00

DAGUE NO.1
14-20S-33W
Scott County, Kansas
Penn Electric Switch Co.

Commenced: Oct. 20, 1944
Completed: Nov. 21, 1944

FORMATION	FROM	TO	FORMATION	FROM	TO
Surface soil and sand	0	45			
Sand and Shale	45	125			
Sand and Gr vel	125	205			
Part rock	205	300			
Gyp and shale	300	460			
Shale	460	510			
Shale and shells	510	700			
Shale and sand	700	850			
Shale and shells	850	1180			
Sand	1180	1300			
Red rock	1300	1380			
Shale and shells	1380	1540			
Anhydrite	1540	1590			
Shale and shells	1590	2075			
Lime	2075	2115			
Red rock	2115	2240			
Lime	2240	2255			
Lime and shale	2255	2275			
Shale and shells	2275	2470			
Shale and lime	2470	2990			
Lime	2990	3010			
Lime and shale	3010	3075			
Lime	3075	3135			
Lime and shale	3135	3160			
Lime	3160	3200			
Lime and shale	3200	3270			
Lime	3270	3650			
Lime and Shale	3650	3695			
Lime	3695	4020			
Lime and shale	4020	4145			
Lime	4145	4705			

STATE OF OKLAHOMA)
COUNTY OF TULSA)^{ss}


I hereby affirm that the above and foregoing is a true and correct copy of the log of your Dague No. 1 well located in the Sec. 14-20S-33W, Scott county, Kansas.

PARKER DRILLING COMPANY

By 

Subscribed and sworn before me, a Notary Public, this 17th day of February, 1945.

My commission expires May 22, 1945

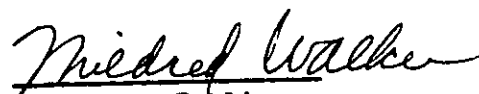
Mildred Walker
Notary Public

14 20 33W
4 37